



City of Prince George  
**History Sheet**

PID:	014156393
SD:	100498
WO:	

Civic Address: 2100 North Nechako Rd

Legal Description: Block: B REM District Lot: 4376 Plan: 1160


Service Type	Diameter (mm)	Material	Invert Elev at main (m)	Invert Elev at property line (m)	Invert Elev at service end (m)	Distance into property (m)	Installation Date
Sanitary	200mm	PVC	-	-	-2.60	3.00	January 1994
Water	N/A	N/A	-	-	-	-	January 1972
Storm	N/A	N/A	-	-	-	-	

Service Connection Location	Sanitary (m)	Storm (m)
200mm Sanitary service connected to San MH 1591	-	
Distance from downstream Stm MH - towards upstream Stm MH -		

Power	Size	Communications	Size	Cable	Size	Gas	Size
BC Hydro	-	Telus	-	Shaw	-	FortisBC	-
Overhead Service		Overhead Service		Overhead Service			

Installed by:	Survey Date:	-
Comments: Old 50mm Galvanized water service disconnected in 2011 as per John Handler		

**NOT TO SCALE** The information contained herein is for internal use only.  
Not to be relied on unless confirmed by site inspection and/or investigation.

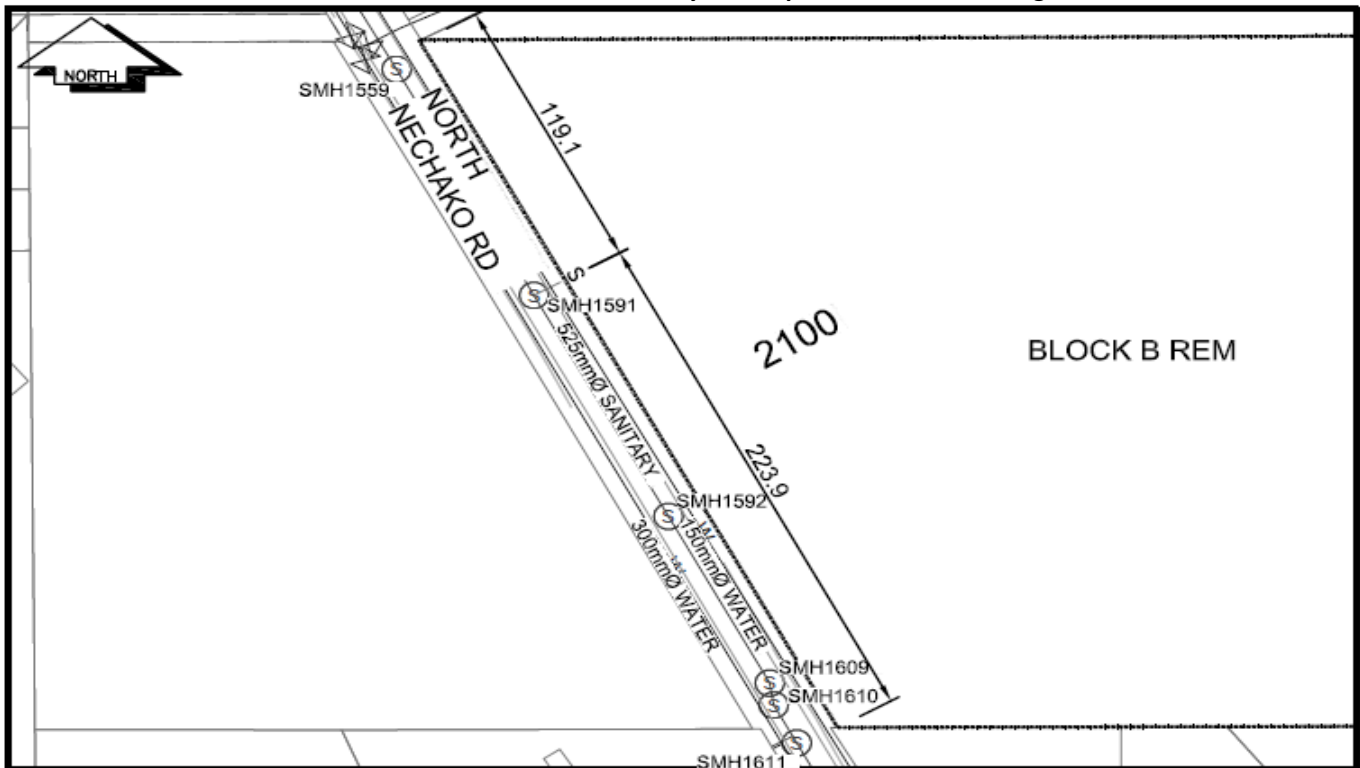

CS	CURB STOP	---	WATER SERVICE	---	STORM SERVICE
CO	CLEAN OUT	---	SANITARY SERVICE	---	GAS

**NOT TO SCALE**