



# City of Prince George History Sheet

|        |           |
|--------|-----------|
| PID:   | 014170027 |
|        | 014170043 |
|        | 014170060 |
| SD/MU: |           |
| WO:    |           |

Civic Address: 2205 Pine St

Legal Description: Lot: 20 - 22 Block: 10 District Lot: 932 Plan: 796


| Service Type | Diameter (mm) | Material | Invert Elev at main (m) | Invert Elev at property line (m) | Invert Depth at service end (m) | Distance into property (m) | Installation Date |
|--------------|---------------|----------|-------------------------|----------------------------------|---------------------------------|----------------------------|-------------------|
| Sanitary     | 100mm         | AC       | -                       | 5672.72                          | 2.35                            | -                          | December 1969     |
| Water        | 20mm          | Copper   | -                       | -                                | -                               | -                          | January 2016      |
| Storm        | N/A           | N/A      | -                       | -                                | -                               | -                          |                   |

| Service Connection Location     |      |                         |      | Sanitary (m) | Storm (m) |
|---------------------------------|------|-------------------------|------|--------------|-----------|
| Distance from downstream San MH | 1462 | towards upstream San MH | 3456 | 32.79        |           |
| Distance from downstream Stm MH | -    | towards upstream Stm MH | -    |              |           |

| Power            | Size | Communications   | Size | Cable            | Size | Gas      | Size |
|------------------|------|------------------|------|------------------|------|----------|------|
| BC Hydro         | -    | Telus            | -    | Shaw             | -    | FortisBC | -    |
| Overhead Service |      | Overhead Service |      | Overhead Service |      |          |      |

|               |              |   |
|---------------|--------------|---|
| Installed by: | Survey Date: | - |
| Comments:     |              |   |
|               |              |   |
|               |              |   |

**NOT TO SCALE** The information contained herein is for internal use only.  
Not to be relied on unless confirmed by site inspection and/or investigation.

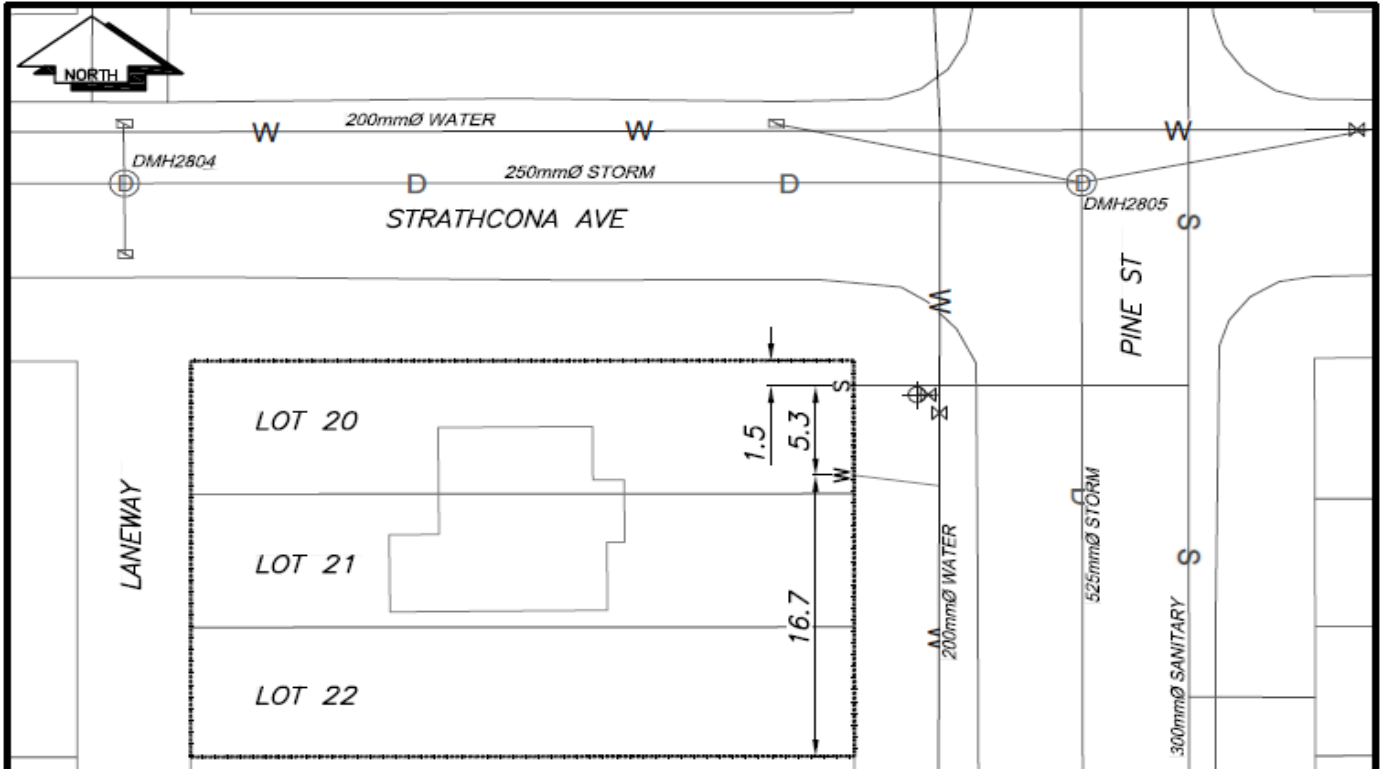

|                           |                        |                       |
|---------------------------|------------------------|-----------------------|
| CS <sup>o</sup> CURB STOP | — W — WATER SERVICE    | — S — STORM SERVICE   |
| CO <sup>o</sup> CLEAN OUT | — S — SANITARY SERVICE | — G — GAS             |
| ⊗ WATER VALVE             | ⊗ FIRE HYDRANT         | — — — — — ENCUMBRANCE |

**NOT TO SCALE**