

City of Prince George HISTORY SHEET

JK

SHEET NUMBER

Roll Number

Legal: LOT'S 13-14 BLOCK 1 D.L. 934 PLAN 701

Address: 1488 - MC CULLAGH AVE

Sanitary Connection: # 6969 SIZE 100mm MATERIAL A.L. INV. 566.945 CONNECTED

Water Connection # 6969 SIZE 20mm MATERIAL CU. METER CONNECTED

Storm Connection: # SIZE MATERIAL INV. CONNECTED

Cash Receipt No's: WATER SANITARY STORM

CURB FROM PROPERTY LINE 7.010m PAVEMENT WIDTH 10.363

B.C. HYDRO O/H UNDERGROUND CONNECTION



B.C. TELEPHONE O/H UNDERGROUND CONNECTION

INLAND GAS 3.657m FROM R.

Information Sheets:

Comments: WITH THAW WIRE.

**THE INFORMATION CONTAINED HEREIN IS FOR INTERNAL USE ONLY.
NOT TO BE RELIED UPON UNLESS CONFIRMED BY SITE INSPECTION AND/OR INVESTIGATION**

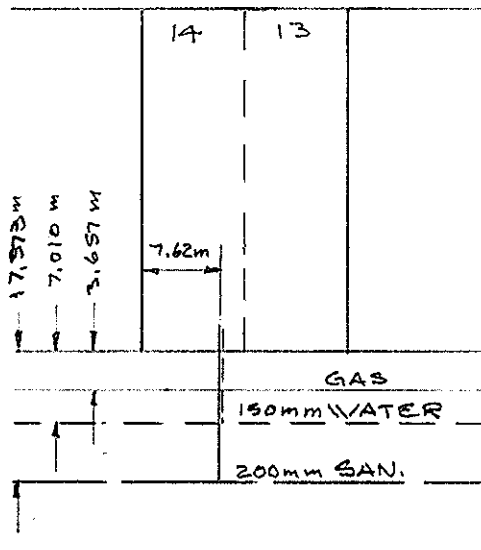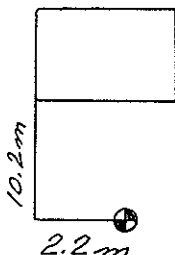

MC CULLAGH
AVE.