

City of Prince George HISTORY SHEET

01/10/2001

SHEET NUMBER

Roll Number

Legal: LOT'S 8+9 BLOCK 14 D.L. 934 PLAN 701

Address: 2542 HAZELTON ST.

Sanitary Connection: # SIZE 150mm MATERIAL A.C. INV. CONNECTED

Water Connection # SIZE 20mm MATERIAL Copper METER CONNECTED

Storm Connection: # SIZE MATERIAL INV. CONNECTED

Cash Receipt No's: WATER SANITARY STORM

CURB FROM PROPERTY LINE PAVEMENT WIDTH


B.C. HYDRO UNDERGROUND CONNECTION

B.C. TELEPHONE UNDERGROUND CONNECTION

INLAND GAS

Information Sheets:

Comments: The information contained herein is for internal use only. Not to be relied upon unless confirmed by site inspection and/or investigation.

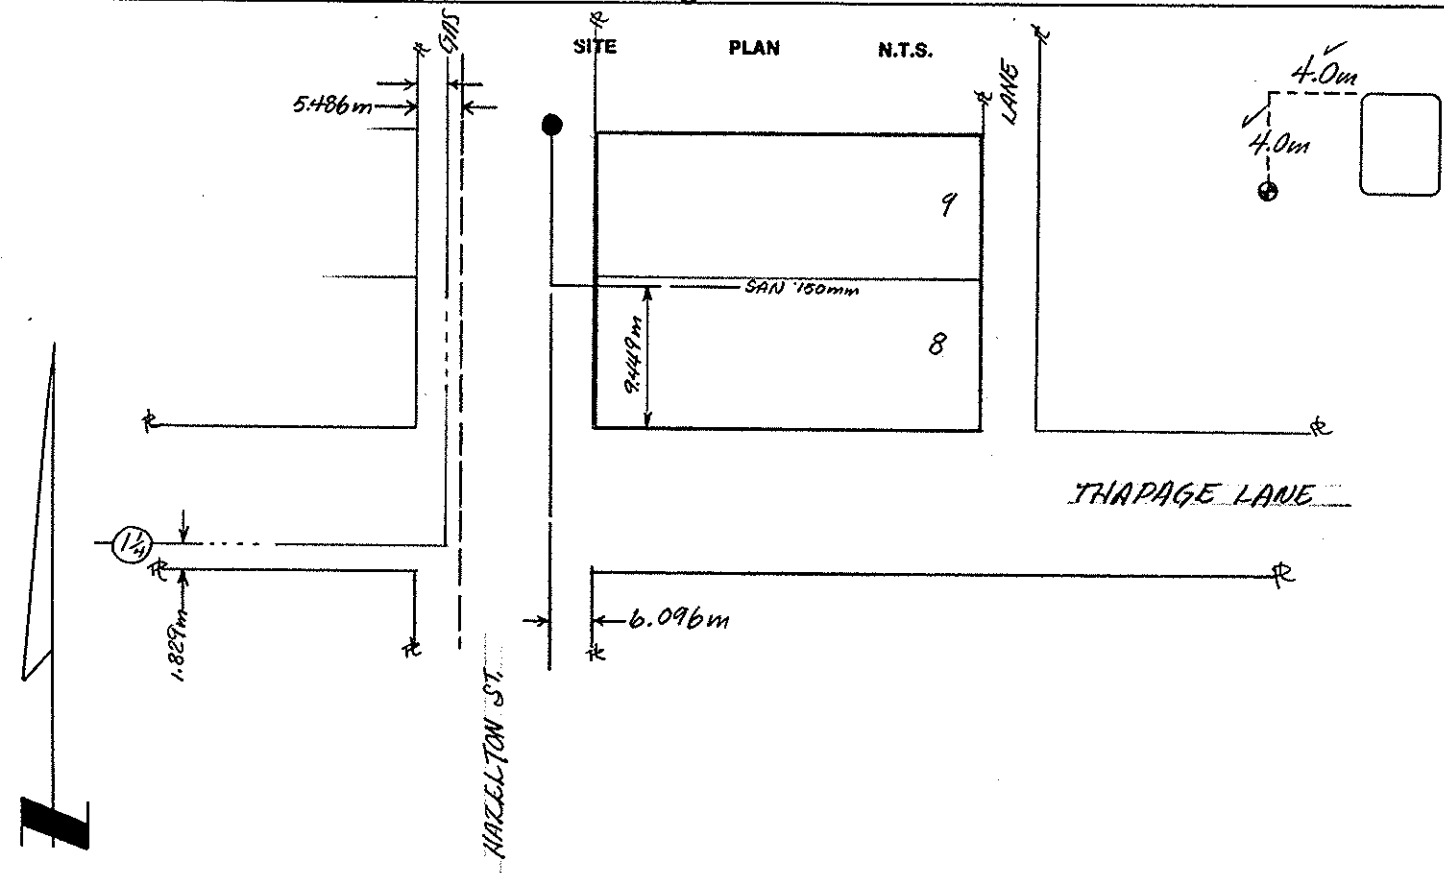

REPORT TO RECORDS

WATER SERVICE INFORMATION

Lot No. 8-9/14/934/701 Block _____ D.L. _____


Address 2542 Hazelton ST

Size of Connection ☐ 1/2" ☒ 3/4" ☐ Other _____

Type of Connection ☒ Copper ☐ Iron

Thaw Wire ☐ Yes ☒ No

LOCATION SKETCH

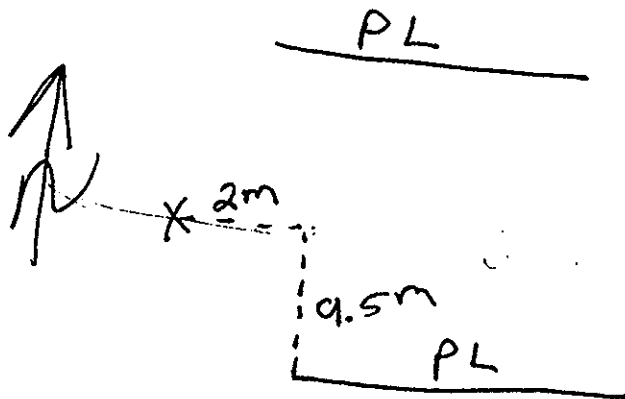

Field Location By DA Date April 1960

Checked by: _____