



City of Prince George
History Sheet

PID:	014210193
	014210215
	014210258
SD/MU:	
WO:	

Civic Address: 2545 15th Ave

Legal Description: Lot: 8, 9, 10 Block: 191 District Lot: 936 Plan: 696


Service Type	Diameter (mm)	Material	Invert Elev at main (m)	Invert Elev at property line (m)	Invert Elev at service end (m)	Distance into property (m)	Installation Date
Sanitary	100mm	AC	-	-	-	-	January 1957
Water	20mm	Copper	-	-	-	-	January 1957
Storm	N/A	N/A	-	-	-	-	

Service Connection Location				Sanitary (m)	Storm (m)
Distance from downstream San MH	870	towards upstream San MH	867	59.05	
Distance from downstream Stm MH	-	towards upstream Stm MH	-		

Power	Size	Communications	Size	Cable	Size	Gas	Size
BC Hydro	-	Telus	-	Shaw	-	FortisBC	-
Overhead Service		Overhead Service		Overhead Service			

Installed by:	Survey Date:	-
Comments:		

NOT TO SCALE The information contained herein is for internal use only.
Not to be relied on unless confirmed by site inspection and/or investigation.

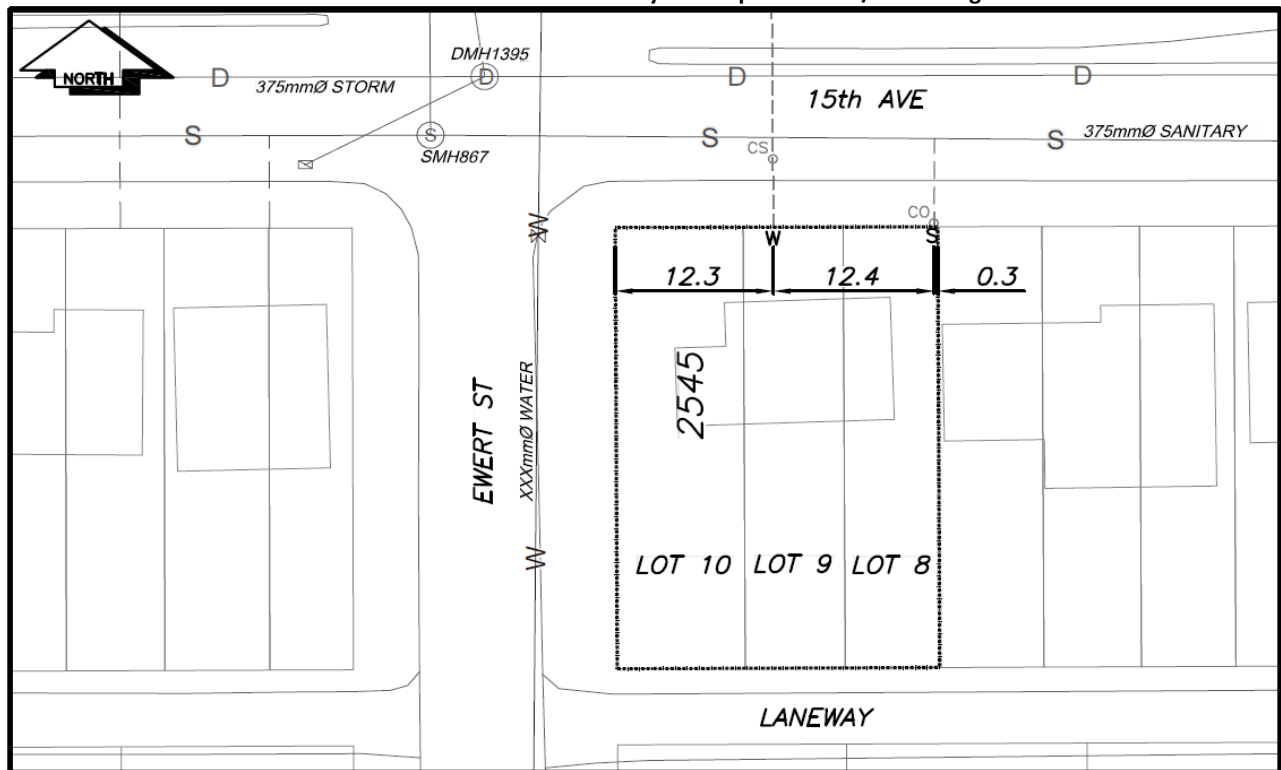

CS	CURB STOP	W	WATER SERVICE	○	STORM SERVICE
CO	CLEAN OUT	S	SANITARY SERVICE	G	GAS
W	WATER VALVE	FH	FIRE HYDRANT	---	ENCUMBRANCE

NOT TO SCALE