


Lot Servicing

2774 OAK ST

PID: 014622548

Lot: 8, Block: 8, Plan: 721, DL: 1426

SERVICE	SIZE	MATERIAL	INSTALLED DATE	LOCATION	DETAILS
WATER	20MM	CU	25-Jul-1972	(1985) FR NW COR BLD 14.5M W 4.9M S	CONNECTION NUMBER 7702
SANITARY	100MM	AC		6.096M S OF NW COR PL	CONNECTION # 7685

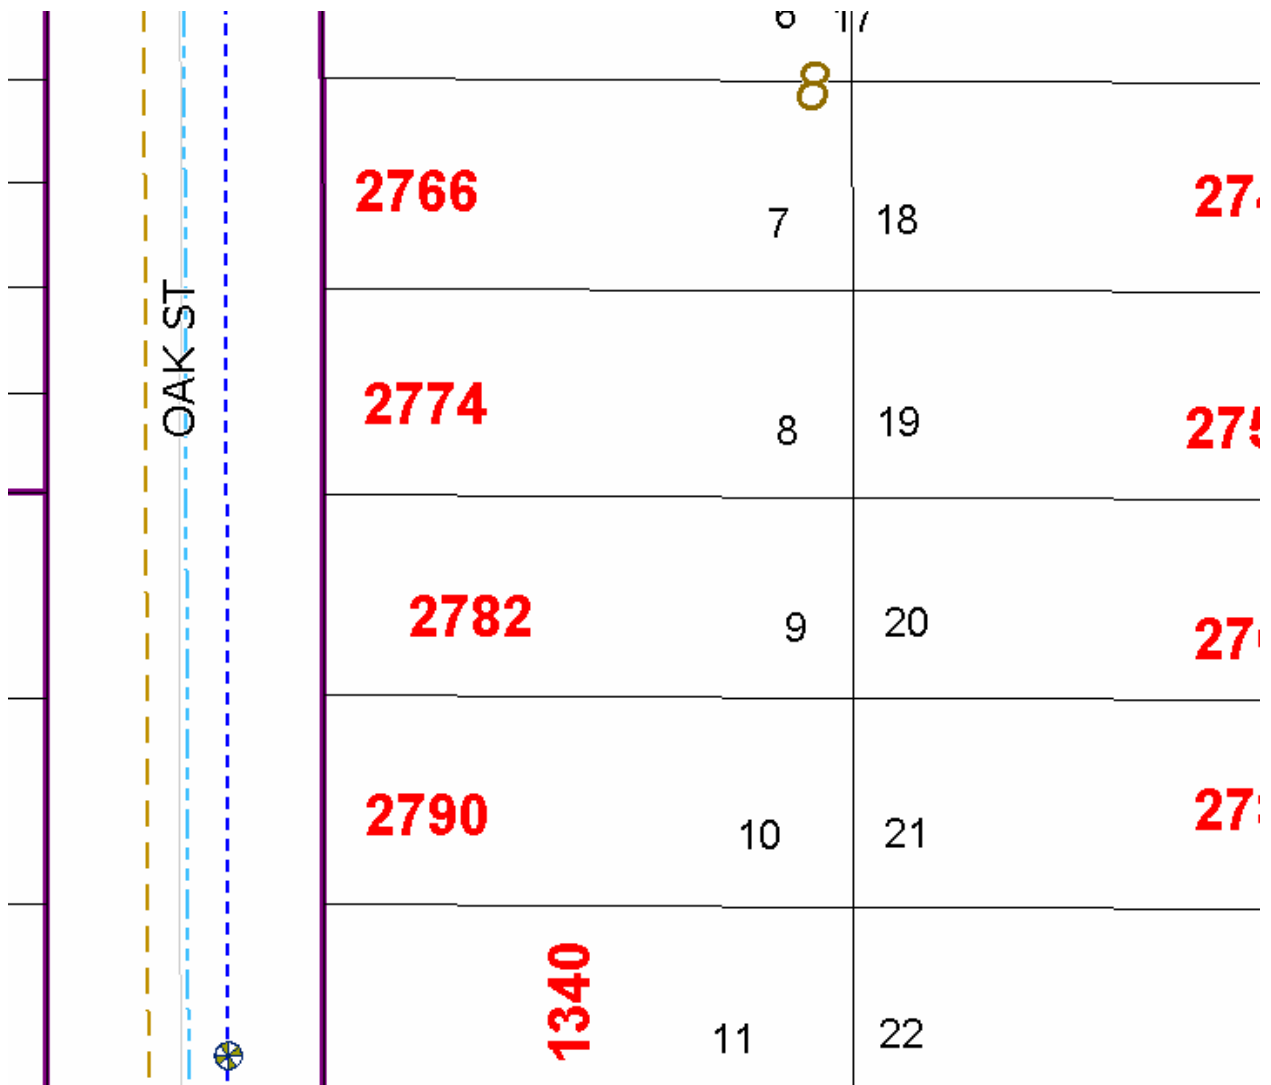

Accuracy not guaranteed unless confirmed by site inspection and/or investigation.
Connection location between main and property line only.