

City of Prince George HISTORY SHEET

17

SHEET NUMBER

Roll Number 014623358

Legal: LOT'S 2 BLOCK 5 D.L. 1426 PLAN 721

Address: 2724 VICTORIA ST.

Sanitary Connection: # 7697 SIZE 100 mm MATERIAL A.C. INV. 574.751 CONNECTED ✓

Water Connection # 7714 SIZE 20 mm MATERIAL C.U. METER CONNECTED ✓

Storm Connection: # SIZE MATERIAL INV. CONNECTED

Cash Receipt No's: WATER SANITARY 203 STORM

CURB FROM PROPERTY LINE 4.877 m PAVEMENT WIDTH 10.363 m

B.C. HYDRO 0/H UNDERGROUND CONNECTION



B.C. TELEPHONE 0/H UNDERGROUND CONNECTION

INLAND GAS 3.657 m FROM R.L.

Information Sheets:

Comments:

THE INFORMATION CONTAINED HEREIN IS FOR INTERNAL USE ONLY.
NOT TO BE RELIED UPON UNLESS CONFIRMED BY SITE INSPECTION AND/OR INVESTIGATION

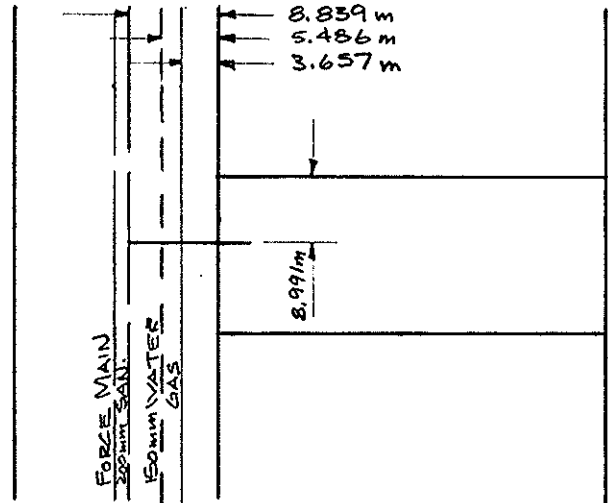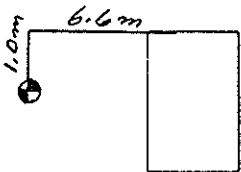

VICTORIA ST.