

**City of Prince George  
HISTORY SHEET**

SHEET NUMBER

Roll Number 314623404

Legal: LOT'S 6 BLOCK 4 D.L. 1426 PLAN 721

Address: 2638 - 2642 OAK STREET

Sanitary Connection: # SIZE MATERIAL INV. CONNECTED

Water Connection # SIZE 20mm MATERIAL Cu METER CONNECTED

Storm Connection: # SIZE MATERIAL INV. CONNECTED

Cash Receipt No's: WATER SANITARY STORM

CURB FROM PROPERTY LINE PAVEMENT WIDTH


B.C. HYDRO UNDERGROUND CONNECTION

B.C. TELEPHONE UNDERGROUND CONNECTION

INLAND GAS

Information Sheets:

Comments:

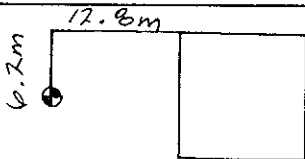

SITE

PLAN

N.T.S.

