

City of Prince George
HISTORY SHEET

1974 SFC

271

77

SHEET NUMBER **8171** Roll Number **259**

Legal: LOT'S **3 + 4** BLOCK **15** D.L. **933** PLAN **727**

Address: **855 Lasalle**

Sanitary Connection: # SIZE **4"** MATERIAL **AC** INV. CONNECTED **1971**

Water Connection # SIZE **3/4"** MATERIAL **CU** METER CONNECTED **yes**

Storm Connection: # SIZE MATERIAL INV. CONNECTED

Cash Receipt No's: WATER **po** SANITARY **po** STORM

CURB FROM PROPERTY LINE PAVEMENT WIDTH

B.C. HYDRO **04** UNDERGROUND CONNECTION

B.C. TELEPHONE **04** UNDERGROUND CONNECTION

INLAND GAS

Information Sheets:

Comments:

The information contained herein is
for internal use only. Not to be
relied upon unless confirmed by site
inspection and/or investigation.



SITE PLAN N.T.S.

Server

Water

6.2m

06/04/86

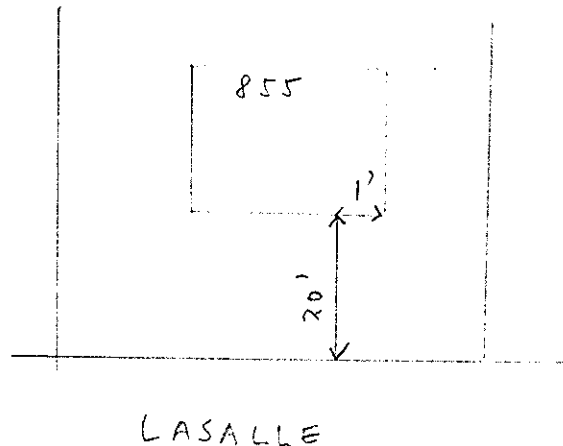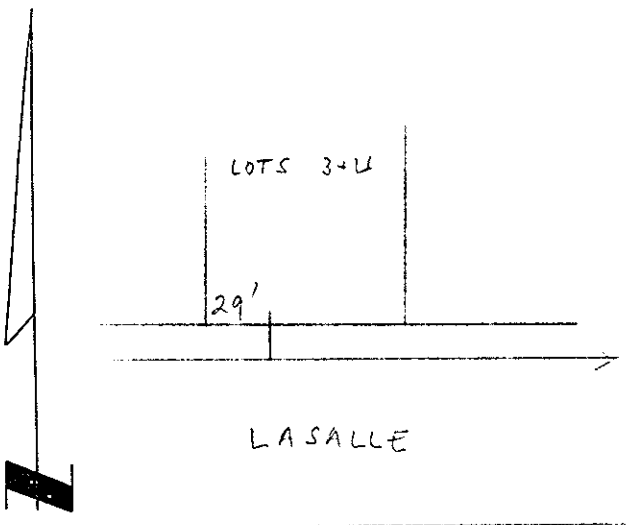

SKETCHES
REVERSED