



# City of Prince George History Sheet

PID:	014779200
SD/MU:	
WO:	

Civic Address: 970 972 North Nechako Road  
Legal Description: Lot: 12 District Lot: 3050 Plan: 8332


Service Type	Diameter (mm)	Material	Invert Elev at main (m)	Invert Elev at property line (m)	Invert Depth at service end (m)	Distance into property (m)	Installation Date
Sanitary	100mm	PVC	-	580.02	1.30	-	August 1993
Water	20mm	Copper	-	-	-	-	January 1972
Storm	N/A	N/A	-	-	-	-	

Service Connection Location				Sanitary (m)	Storm (m)
Distance from downstream San MH	2162	towards upstream San MH	213	0.00	
Distance from downstream Stm MH	-	towards upstream Stm MH	-		

Power	Size	Communications	Size	Cable	Size	Gas	Size
BC Hydro	-	Telus	-	Shaw	-	FortisBC	-
Overhead Service		Overhead Service		Overhead Service			

Installed by:	Survey Date:	-
Comments:		

**NOT TO SCALE** The information contained herein is for internal use only.  
Not to be relied on unless confirmed by site inspection and/or investigation.

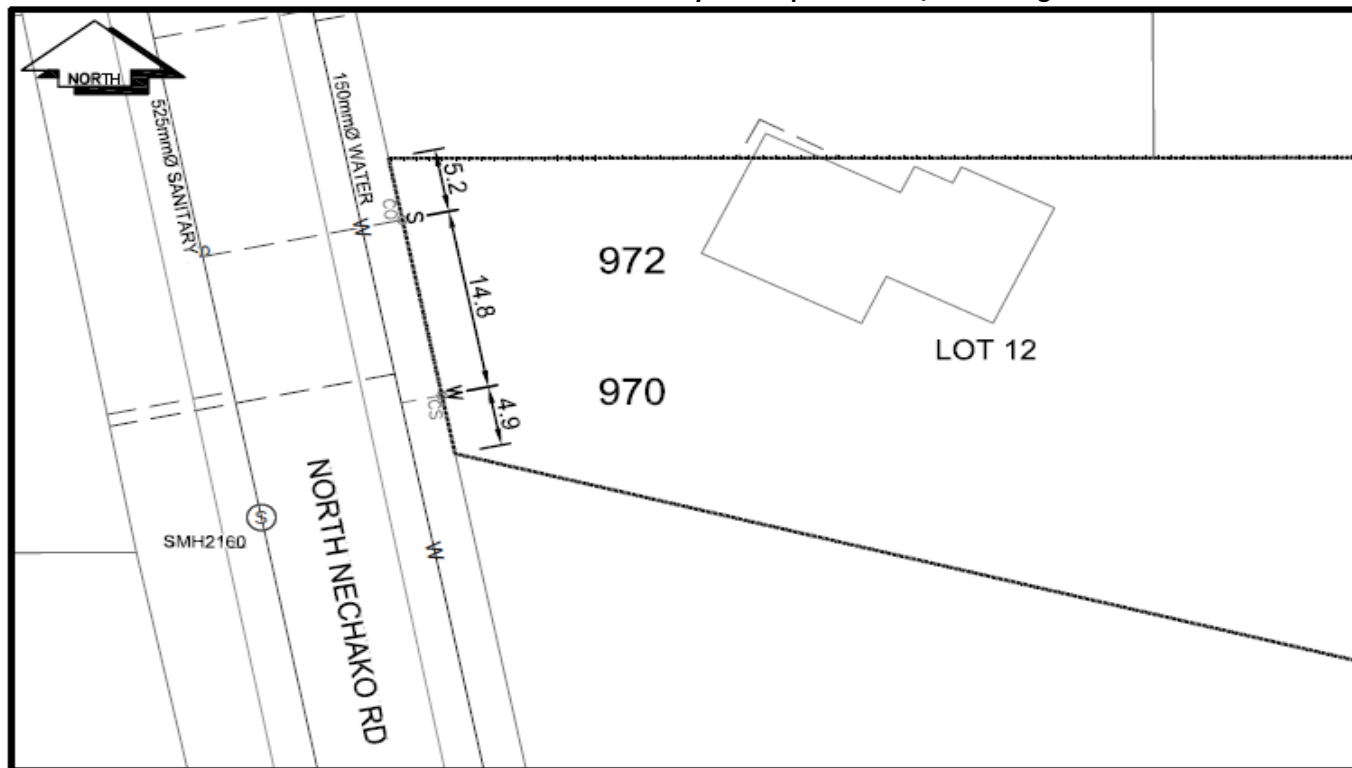

CS	CURB STOP	---	W	WATER SERVICE	---	S	SANITARY SERVICE	---	G	GAS	---	CS	STORM SERVICE
CO	CLEAN OUT	---	S	SANITARY SERVICE	---	G	GAS	---	CS	STORM SERVICE	---	CS	STORM SERVICE
W	WATER VALVE	---	CS	FIRE HYDRANT	---	CS	STORM SERVICE	---	CS	STORM SERVICE	---	CS	STORM SERVICE

**NOT TO SCALE**