



CITY OF
PRINCE GEORGE

Civic Address: 4540 BUBA ROAD

Legal Description: District Lot: 4040 REM NE 4

Lot Services Sketch

PID:

015101568


Service Type	Diameter (mm)	Material	Invert Elev @ Main (m)	Invert Elev @ Property Line (m)	Invert Elev @ Service End (m)	Distance into Property (m)	Installation Date
Sanitary	Unknown	Unknown	-	-	-	-	Unknown
Water	19	COPPER	-	-	-	-	Unknown
Storm	N/A	-	-	-	-	-	-

Sanitary Service Connection Location Notes	Storm Service Connection Location Notes
Distance from downstream SAN MH #: Unknown	Distance from downstream STM MH #: N/A
Distance to upstream SAN MH #: Unknown	Distance to upstream STM MH #: N/A

Miscellaneous Utilities			
Power	Communications	Cable	Gas
BC Hydro	TELUS	Shaw Cable	FortisBC
Overhead Service	Overhead Service	Overhead Service	Underground Service

Installation By:	Unknown	Survey Date:	2022-06-14
Comments:			
Water Service is ~0.6m from the South West corner of Lot A (4560 Buba Rd). Sanitary Service not found.			
Inspection #4229846 completed 2022-06-14.			

NOT TO SCALE The information contained herein is for internal use only.
Not to be relied on unless confirmed by site inspection and/or investigation.

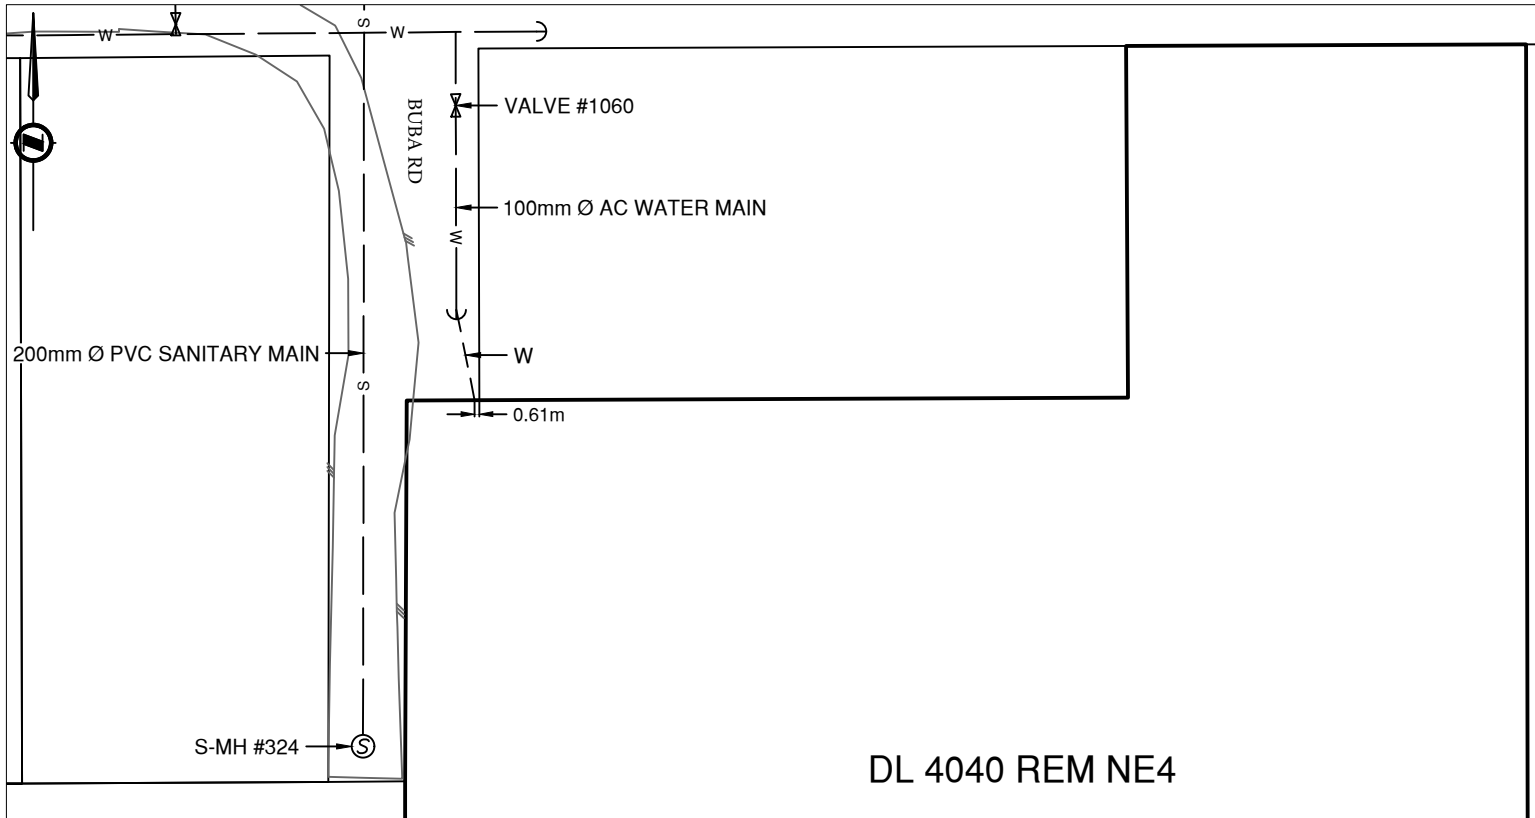

—●— WATER SERVICE AND CURB STOP (CS)	— G — UNDERGROUND GAS LINE
—●— WATER HYDRANT LEAD, VALVE, HYDRANT	— W — WATER MAIN
—●— SANITARY SERVICE AND CLEAN OUT (CO)	— S — SANITARY MAIN
—□— STORM SERVICE	— D — STORM MAIN
— ROAD EDGE	— ENCUMBRANCE