

Roll Number

LOT'S

6102 MONTEREY ROAD

SIZE 150mm

SIZE 50mm

SIZE 200

WATER

6.0m


N/A

N/A

U.G.

Comments:

THE INFORMATION CONTAINED HEREIN IS FOR INTERNAL USE ONLY.
NOT TO BE RELIED UPON UNLESS CONFIRMED BY SITE INSPECTION AND/OR INVESTIGATION

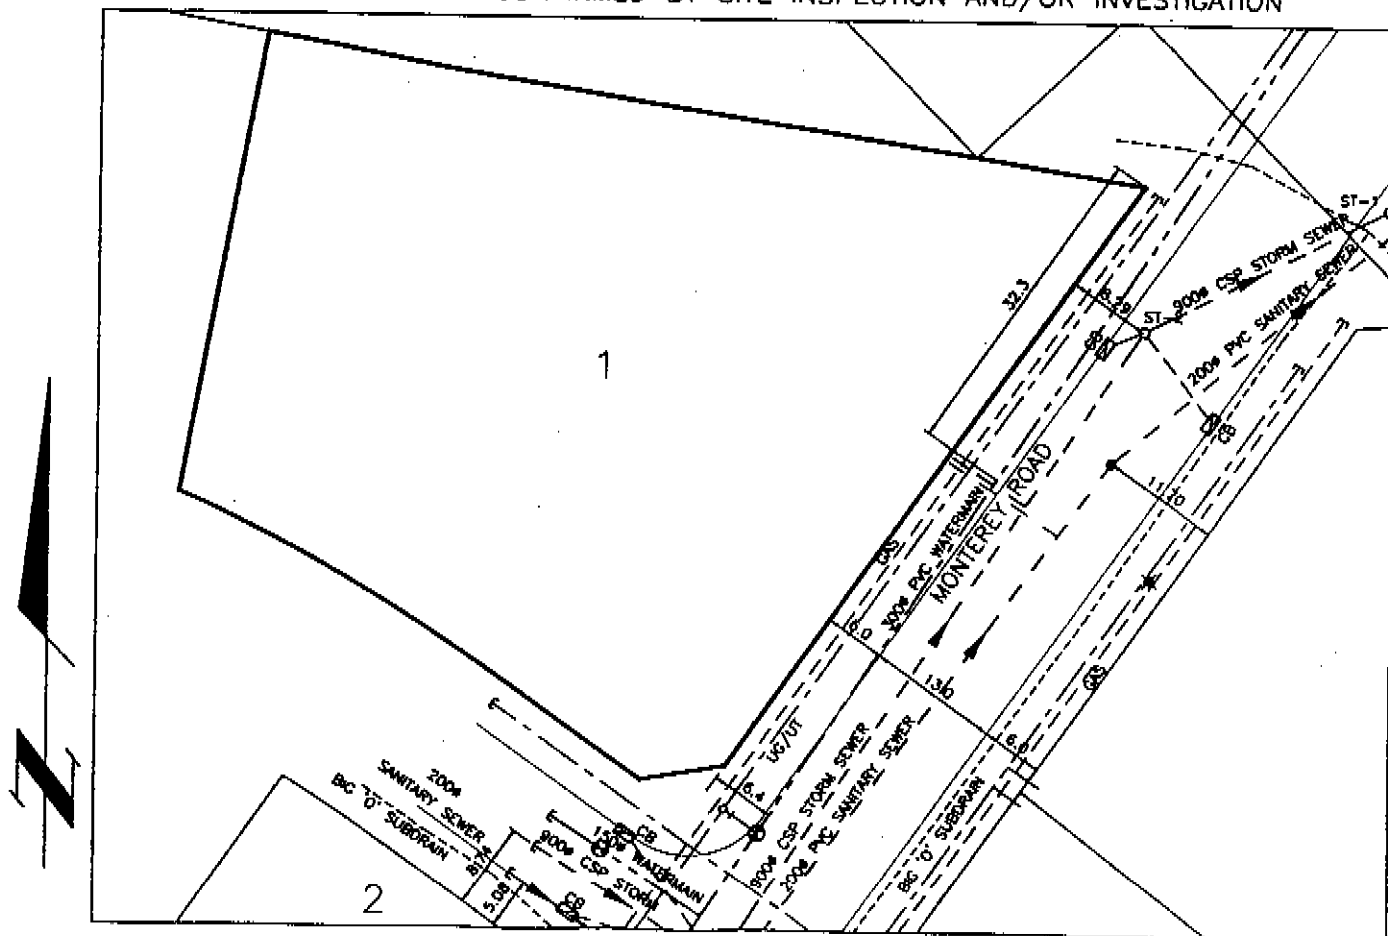

City of Prince George

HISTORY SHEET

①

SHEET NUMBER _____ Roll Number _____

Legal: LOT'S 3 BLOCK D.L. 4039 PLAN

Address: 6101 MONTEREY ROAD

Sanitary Connection: SIZE 150mm MATERIAL PVC INV. 695.53 CONNECTED Y

Water Connection: SIZE 50mm MATERIAL Cu METER CONNECTED Y

Storm Connection: SIZE 200mm MATERIAL INV. CONNECTED N

Cash Receipt No's: WATER SANITARY STORM

CURB FROM PROPERTY LINE 6.0m PAVEMENT WIDTH 13.0m

B.C. HYDRO U.G. UNDERGROUND CONNECTION


B.C. TELEPHONE U.G. UNDERGROUND CONNECTION

INLAND GAS U.G.

Information Sheets:

Comments:

THE INFORMATION CONTAINED HEREIN IS FOR INTERNAL USE ONLY.
NOT TO BE RELIED UPON UNLESS CONFIRMED BY SITE INSPECTION AND/OR INVESTIGATION

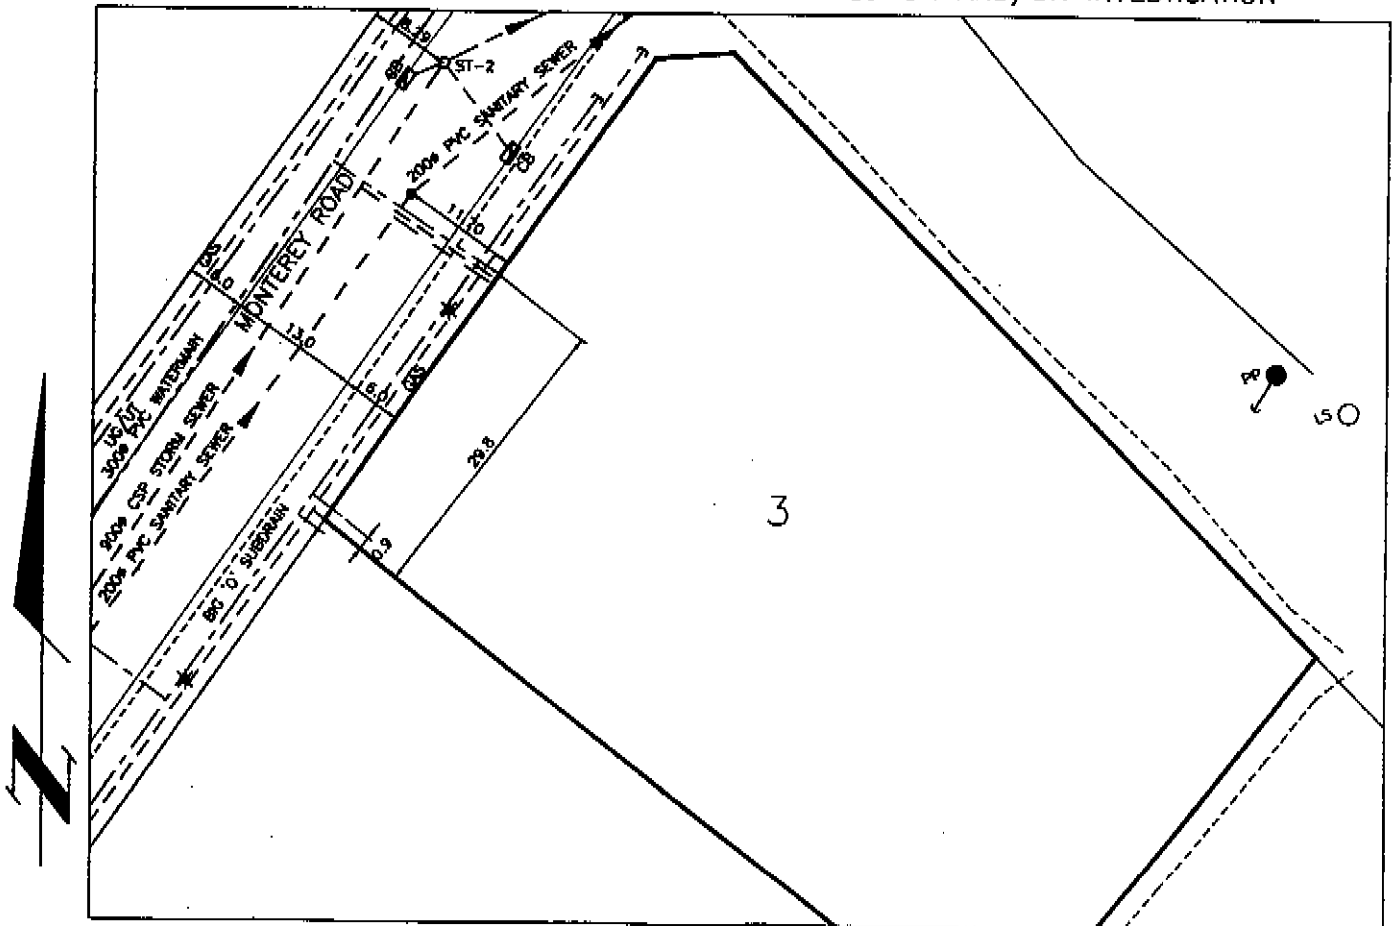

City of Prince George

HISTORY SHEET

D

SHEET NUMBER

Roll Number

Legal: LOT'S 2 BLOCK D.L. 4039 PLAN

Address: 6155 MONTEREY ROAD

Sanitary Connection: SIZE 150mm MATERIAL PVC INV. 694.29 CONNECTED Y

Water Connection: SIZE 50mm MATERIAL Cu METER CONNECTED Y

Storm Connection: SIZE 200 MATERIAL PVC INV. 694.81 CONNECTED Y

Cash Receipt No's: WATER SANITARY STORM

CURB FROM PROPERTY LINE 6.0m PAVEMENT WIDTH 13.0m

B.C. HYDRO U.G. UNDERGROUND CONNECTION

B.C. TELEPHONE U.G. UNDERGROUND CONNECTION

INLAND GAS U.G.

Information Sheets:

Comments:

THE INFORMATION CONTAINED HEREIN IS FOR INTERNAL USE ONLY.
NOT TO BE RELIED UPON UNLESS CONFIRMED BY SITE INSPECTION AND/OR INVESTIGATION

