


Lot Servicing

2477 PERRIN RD
DL: 4040 REM NE4SW4

PID: 015217728

SERVICE	SIZE	MATERIAL	INSTALLED DATE	LOCATION	DETAILS
WATER	20MM	CU	14-Oct-1981	1.828M W OF E COR PL	CASH RECEIPT NUMBER 3481
SANITARY	100MM	AC		10.363M E OF NW COR PL	CONNECTION # 13125

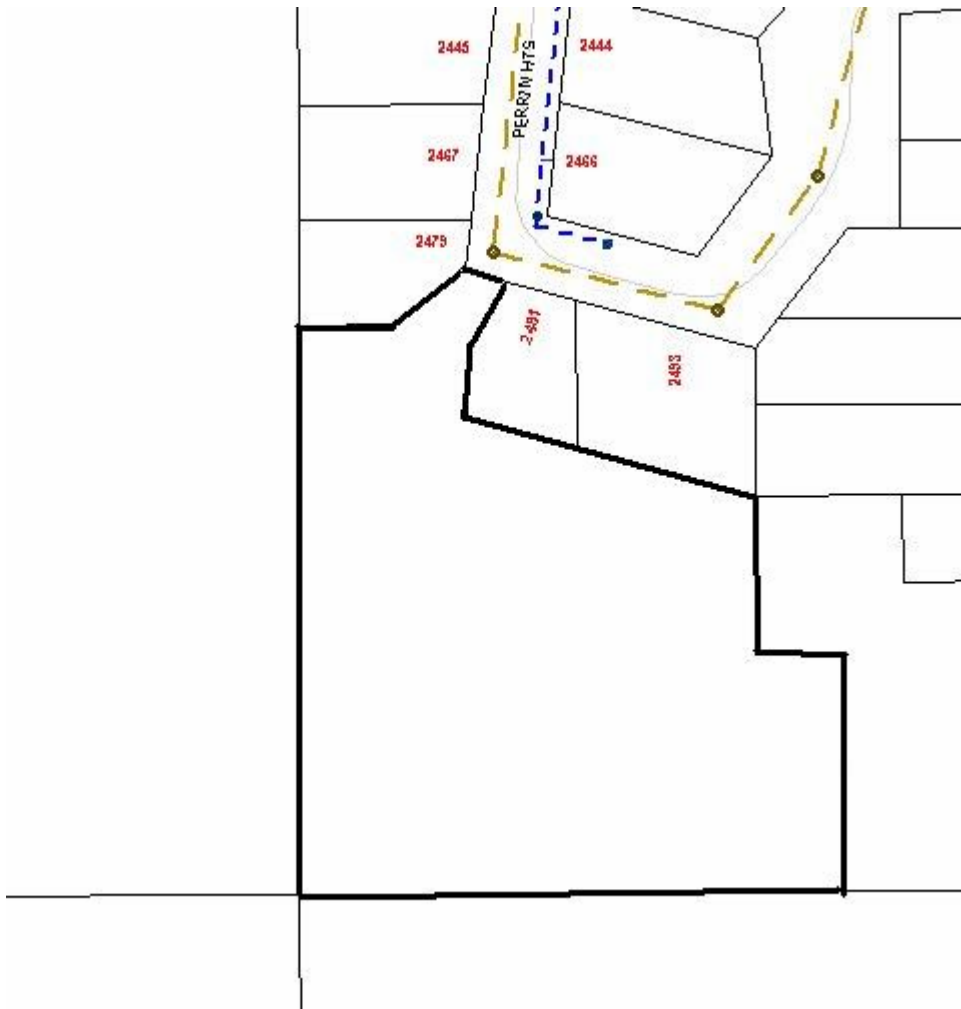

Accuracy not guaranteed unless confirmed by site inspection and/or investigation.
Connection location between main and property line only.