
Lot Servicing

1882 KUENG RD PID: 015287106

DL: 10227

SERVICE	SIZE	MATERIAL	INSTALLED DATE	LOCATION	DETAILS
WATER	50MM	СП	10-0ct-2007	SERVICE THRU EASEMENT AT 5053 CREST RD	CASH RECEIPT NUMBER 100776

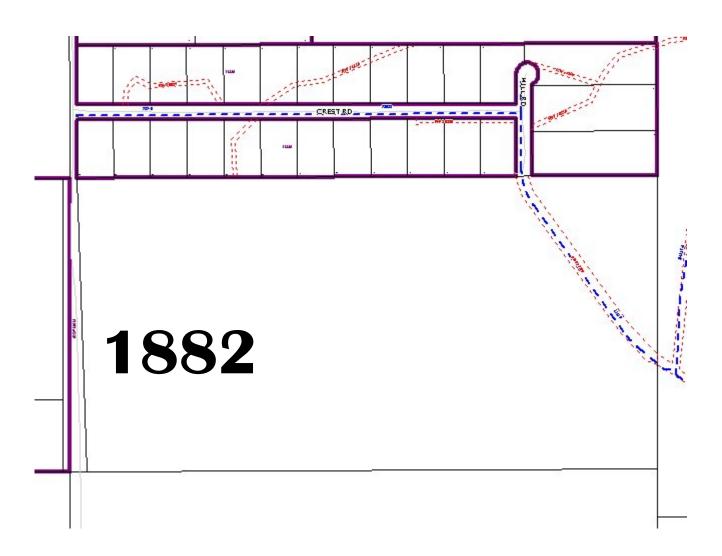

Accuracy not guaranteed unless confirmed by site inspection and/or investigation. Connection location between main and property line only.