



City of Prince George History Sheet

PID:	015743292
	015743268
SD/MU:	
WO:	

Civic Address: 540, 550 3rd Ave

Legal Description: Lot: 14, 15 Block: 37 District Lot: 343 Plan: 1268


Service Type	Diameter (mm)	Material	Invert Elev at main (m)	Invert Elev at property line (m)	Invert Elev at service end (m)	Distance into property (m)	Installation Date
Sanitary (S1)	100mm	AC	-	566.41	-	-	December 1965
Water (W1)	20mm	Copper	-	-	-	-	December 1965
Sanitary (S2)	100mm	AC	-	566.88	-	-	December 1965
Water (W2)	20mm	Copper	-	-	-	-	December 1965
Storm	N/A	N/A	-	-	-	-	

Service Connection Location				Sanitary (m)	Storm (m)
Distance from downstream San MH	626	towards upstream San MH	624	44.07	
Distance from downstream San MH	626	towards upstream San MH	624	41.06	

Power	Size	Communications	Size	Cable	Size	Gas	Size
BC Hydro	-	Telus	-	Shaw	-	FortisBC	-
Overhead Service		Overhead Service		Overhead Service			

Installed by:	Survey Date:	-
Comments:		

NOT TO SCALE The information contained herein is for internal use only.
Not to be relied on unless confirmed by site inspection and/or investigation.

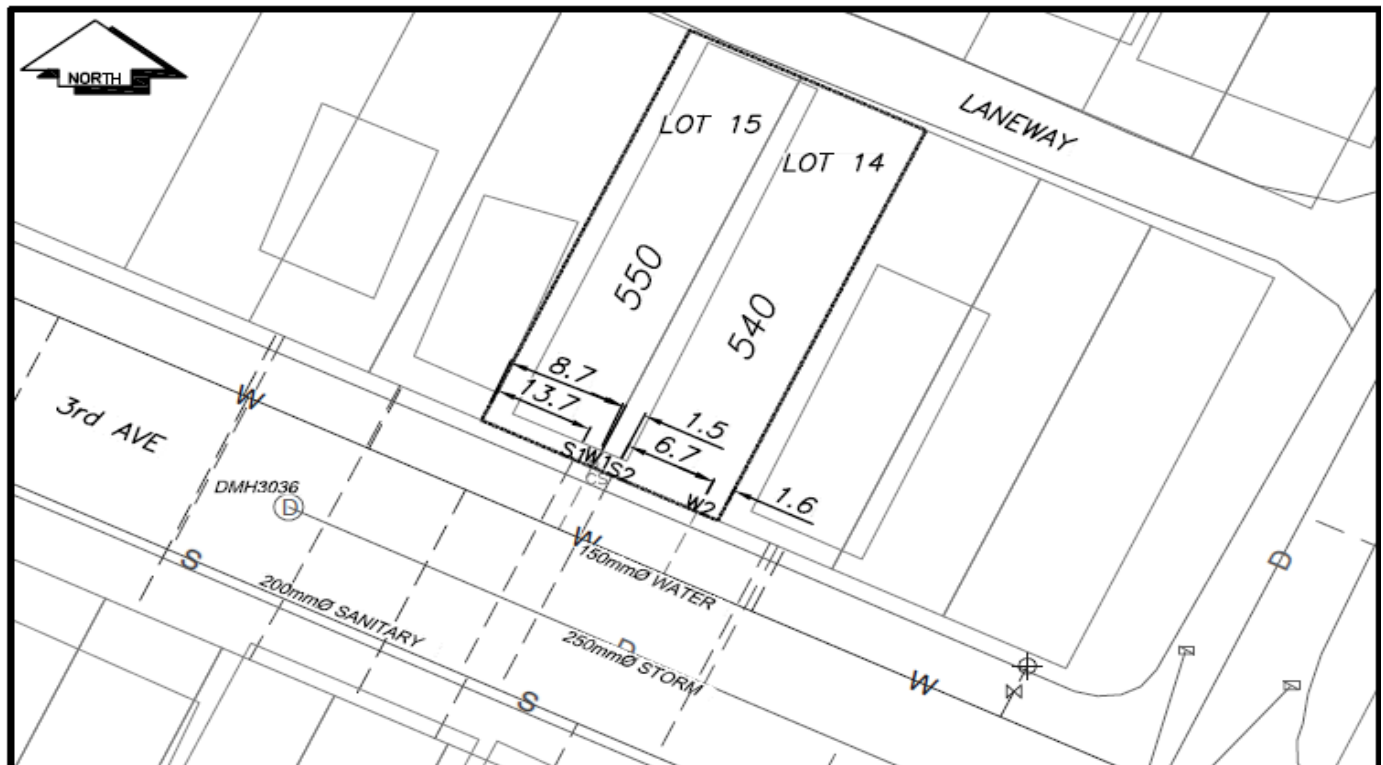

CS ^o CURB STOP	—X— WATER SERVICE	—o— STORM SERVICE
CO ^o CLEAN OUT	- - - - - SANITARY SERVICE	—G— GAS
⊗ WATER VALVE	—X⊗— FIRE HYDRANT	- - - - - ENCUMBRANCE

NOT TO SCALE