
City of Prince George HISTORY SHEET

HEET NUMBER			Roll Number (7/59// 888		
Legal: LOT'S 7	вьоск 4	D.L.	1426 PLA	N 721	
Address: 2646	OAK 4	3T.			
Sanitary Connection: # 9543	SIZE 100 mm	MATERIAL ALL	· INV.	CONNECTED	
Water Connection # 9543	SIZE ZOMM	MATERIAL CU	METER	CONNECTED	
Storm Connection: #	SIZE	MATERIAL	INV.	CONNECTED	
Cash Receipt No's: WATER	s	ANITARY	STORM		
CURB FROM PROPERTY LINE 4, 877	M·		PAVEMENT WIDTH	10,363 m	
B.C. HYDRO O/H UNDERGROUND CONNECTION					
B.C. TELEPHONE D/H	UNDERGROUND CONNECTION				
INLAND GAS AS SHOWN					
Information Sheets: WITH THAW WIFE;					
Comments:					

THE INFORMATION CONTAINED HEREIN IS FOR INTERNAL USE ONLY. NOT TO BE RELIED UPON UNLESS CONFIRMED BY SITE INSPECTION AND/OR INVESTIGATION



9.75m

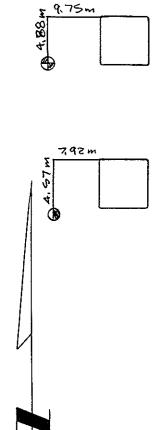