



City of Prince George History Sheet

PID:	015975169
MU:	101912
WO:	93015

Civic Address: 1466 3rd Ave

Legal Description: Lot: 17 Block:46 District Lot: 343 Plan: 1268


Service Type	Diameter (mm)	Material	Invert Elev at main (m)	Invert Elev at property line (m)	Invert Depth at service end (m)	Distance into property (m)	Installation Date
Sanitary	100mm	PVC	-	-	1.82	-	January 1959
Sanitary	100mm	PVC	-	-	1.82	-	January 1959
Sanitary	100mm	PVC	-	-	1.82	-	January 1959
Water	50mm	Copper	-	-	-	-	August 2017
Storm	N/A	N/A	-	-	-	-	

Service Connection Location				Sanitary (m)	Storm (m)
Distance from downstream San MH	1873	towards upstream San MH	1876	67.25	
Distance from downstream Stm MH	-	towards upstream Stm MH	-		

Power	Size	Communications	Size	Cable	Size	Gas	Size
BC Hydro	-	Telus	-	Shaw	-	FortisBC	-
Overhead Service		Overhead Service		Overhead Service			

Installed by:	City of Prince George forces	Survey Date:	-
Comments:	50mm water service replaced old 20mm water		

NOT TO SCALE The information contained herein is for internal use only.
Not to be relied on unless confirmed by site inspection and/or investigation.

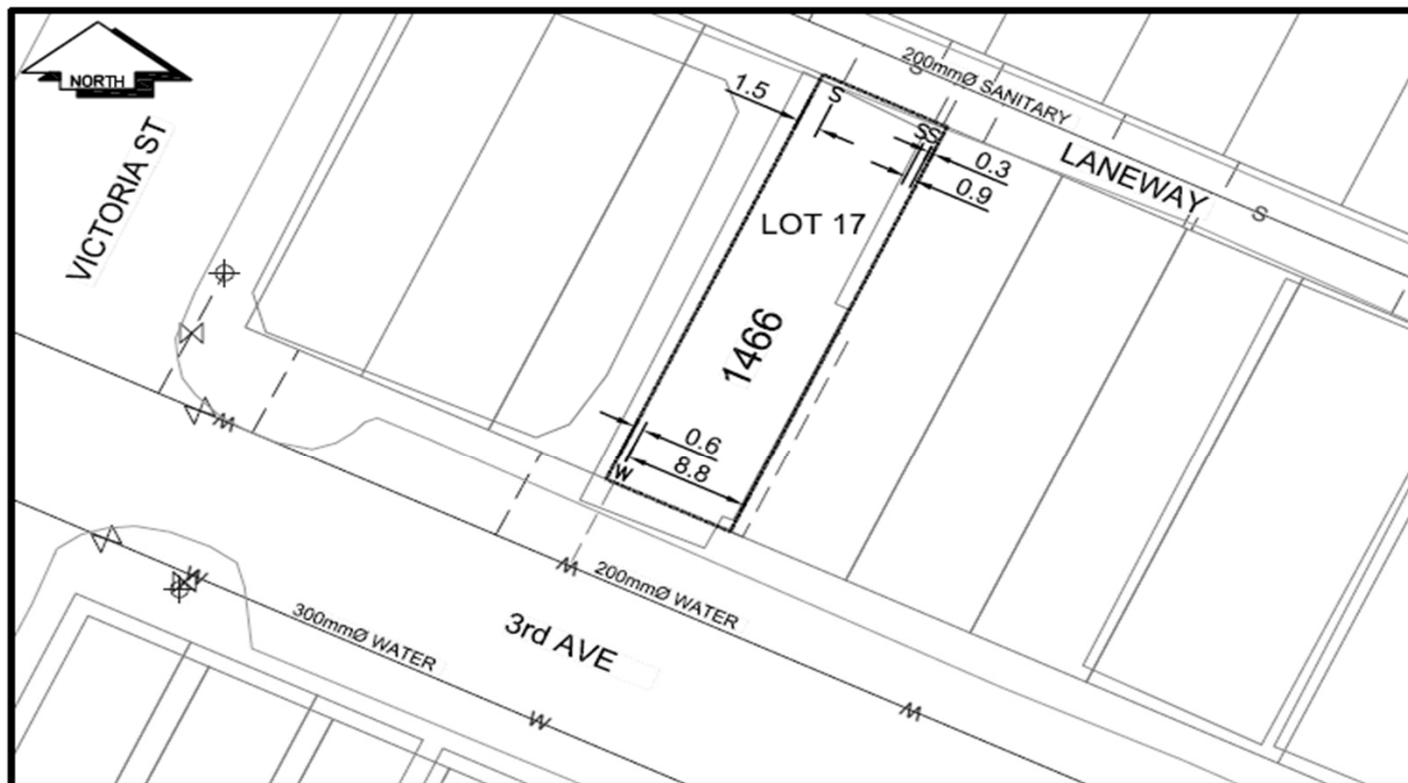

CS ^o CURB STOP	--- S --- WATER SERVICE	--- S --- STORM SERVICE
CO ^o CLEAN OUT	--- S --- SANITARY SERVICE	--- G --- GAS
WATER VALVE	--- S --- FIRE HYDRANT	--- --- ENCUMBRANCE

NOT TO SCALE