



City of Prince George History Sheet

PID:	016378164
SD/MU:	
WO:	

Civic Address: 4589 Zral Rd

Legal Description: Lot: 3 District Lot: 2425 Plan: 34827


Service Type	Diameter (mm)	Material	Invert Elev at main (m)	Invert Elev at property line (m)	Invert Elev at service end (m)	Distance into property (m)	Installation Date
Sanitary	100mm	PVC	-	-	-	3.00	December 1985
Water	20mm	Copper	-	-	-	3.00	December 1985
Storm	N/A	N/A	-	-	-	-	

Service Connection Location				Sanitary (m)	Storm (m)
Distance from downstream San MH	21	towards upstream San MH	20	63.89	
Distance from downstream Stm MH	-	towards upstream Stm MH	-		

Power	Size	Communications	Size	Cable	Size	Gas	Size
BC Hydro	-	Telus	-	Shaw	-	FortisBC	-
Overhead Service		Overhead Service		Overhead Service			

Installed by:	Survey Date:	-
Comments:	Water and Sanitary Service confirmed August 2017	

NOT TO SCALE The information contained herein is for internal use only.
Not to be relied on unless confirmed by site inspection and/or investigation.

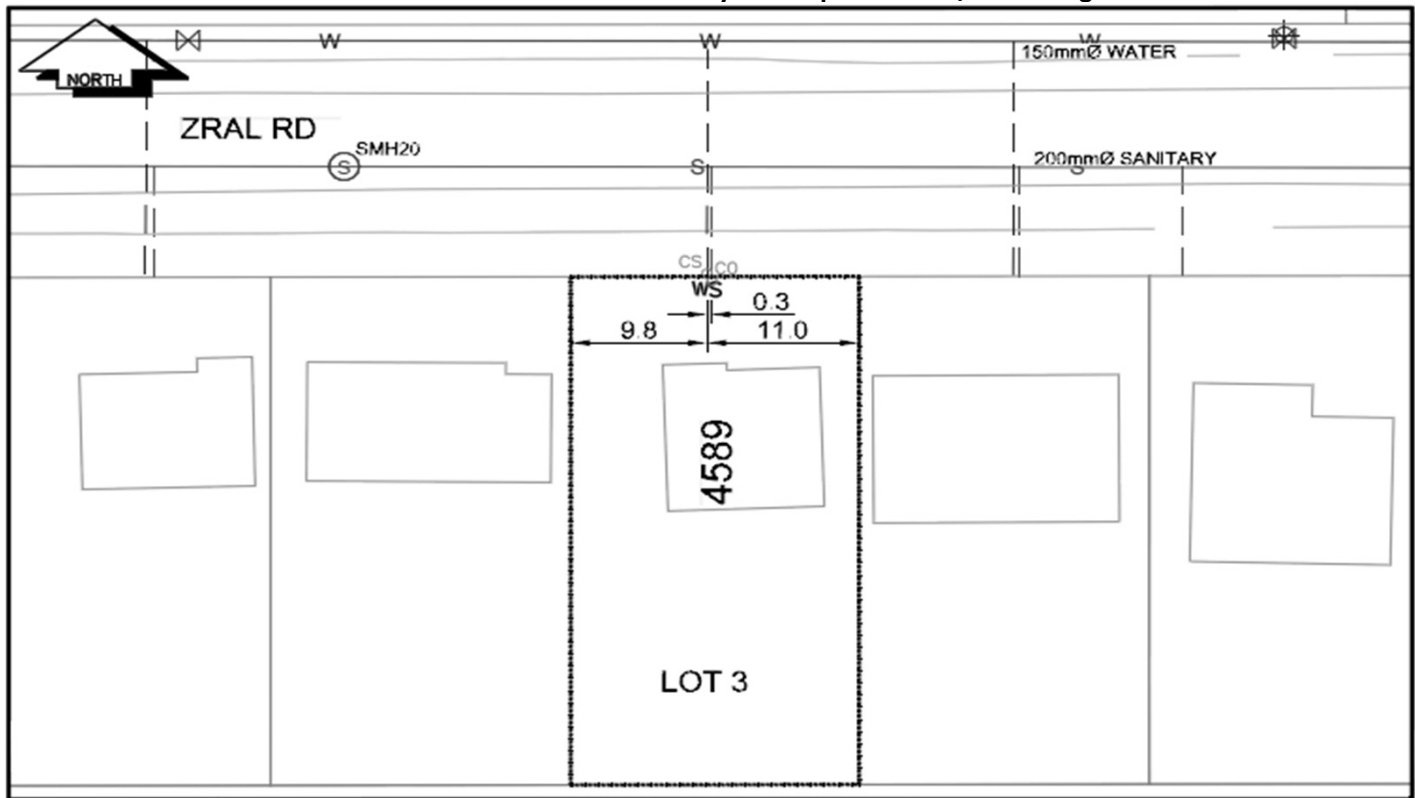

CS	CURB STOP	---	W	WATER SERVICE	---	CS	STORM SERVICE
CO	CLEAN OUT	---	S	SANITARY SERVICE	---	G	GAS
WV	WATER VALVE	---	FH	FIRE HYDRANT	---	---	ENCUMBRANCE

NOT TO SCALE