


Lot Servicing

4150 VERSATILE PL

PID: 017178631

Lot: B, Plan: PGP35231, DL: 753

SERVICE	SIZE	MATERIAL	INSTALLED DATE	LOCATION	DETAILS
WATER	50MM	CU	19-Jun-2007	4.3M S OF N PL SP 5.0M W OF E PL	CASH RECEIPT NUMBER MU100697
SANITARY	100MM	PVC	18-Jun-2007	C/O 3.6M W OF E PL	CLEANOUT Y
STORM	200MM	PVC	18-Jun-2007	4.0M S OF N PL	CONNECTION # 34308

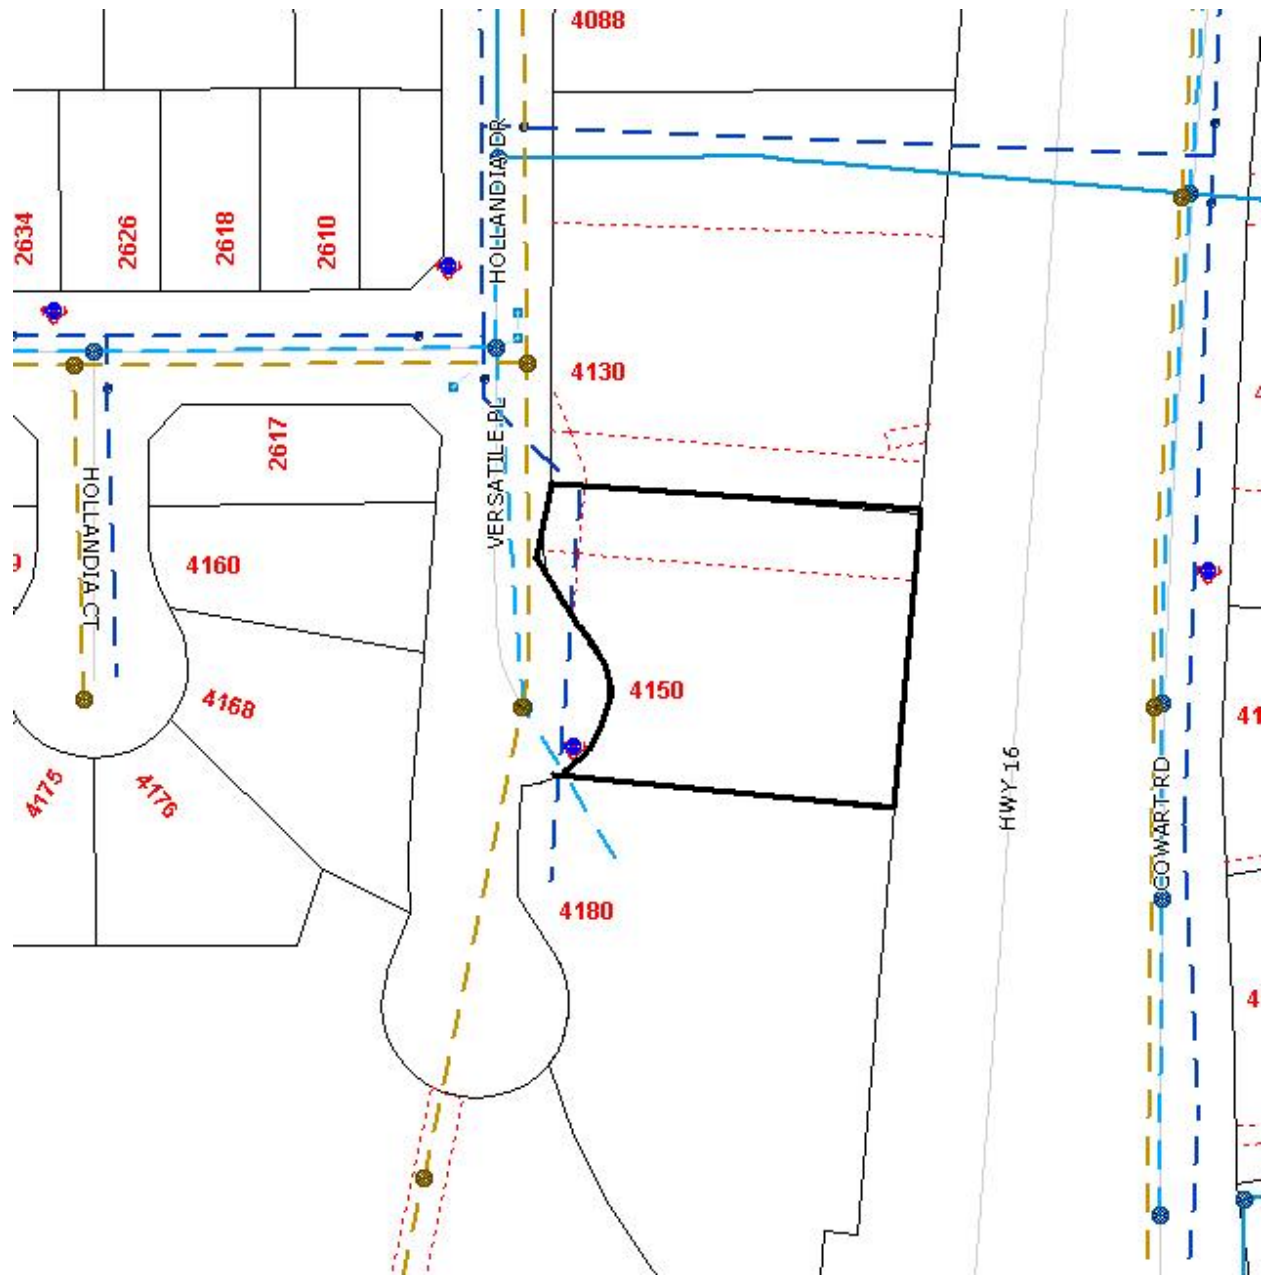

Accuracy not guaranteed unless confirmed by site inspection and/or investigation.
Connection location between main and property line only.