



City of Prince George History Sheet

PID:	017306566
MU:	101489
WO:	78406

Civic Address: 2100 Ogilvie St

Legal Description: Lot: A District Lot: 936 Plan: PGP35309


Service Type	Diameter (mm)	Material	Invert Elev at main (m)	Invert Elev at property line (m)	Invert Depth at service end (m)	Distance into property (m)	Installation Date
Sanitary	100mm	PVC	-	600.51	2.76	-	January 1967
Water	50mm	Copper	-	-	-	-	May 2014
Storm (North)	200mm	CMP	-	600.61	2.93	-	September 1968
Storm (South)	200mm	CMP	-	603.14	3.10	-	September 1968

Service Connection Location				Sanitary (m)	Storm (m)
Distance from downstream San MH	3363	towards upstream San MH	3358	62.15	
Storm service connected to Stm MH 2670					
Distance from downstream Stm MH	2694	towards upstream Stm MH	2680	-	29.39

Power	Size	Communications	Size	Cable	Size	Gas	Size
BC Hydro	-	Telus	-	Shaw	-	FortisBC	-
Overhead Service		Overhead Service		Overhead Service			

Installed by:	City of Prince George forces	Survey Date:	-
Comments:	100mm Sanitary service replaced along with water service upgrade.		

NOT TO SCALE The information contained herein is for internal use only.
Not to be relied on unless confirmed by site inspection and/or investigation.

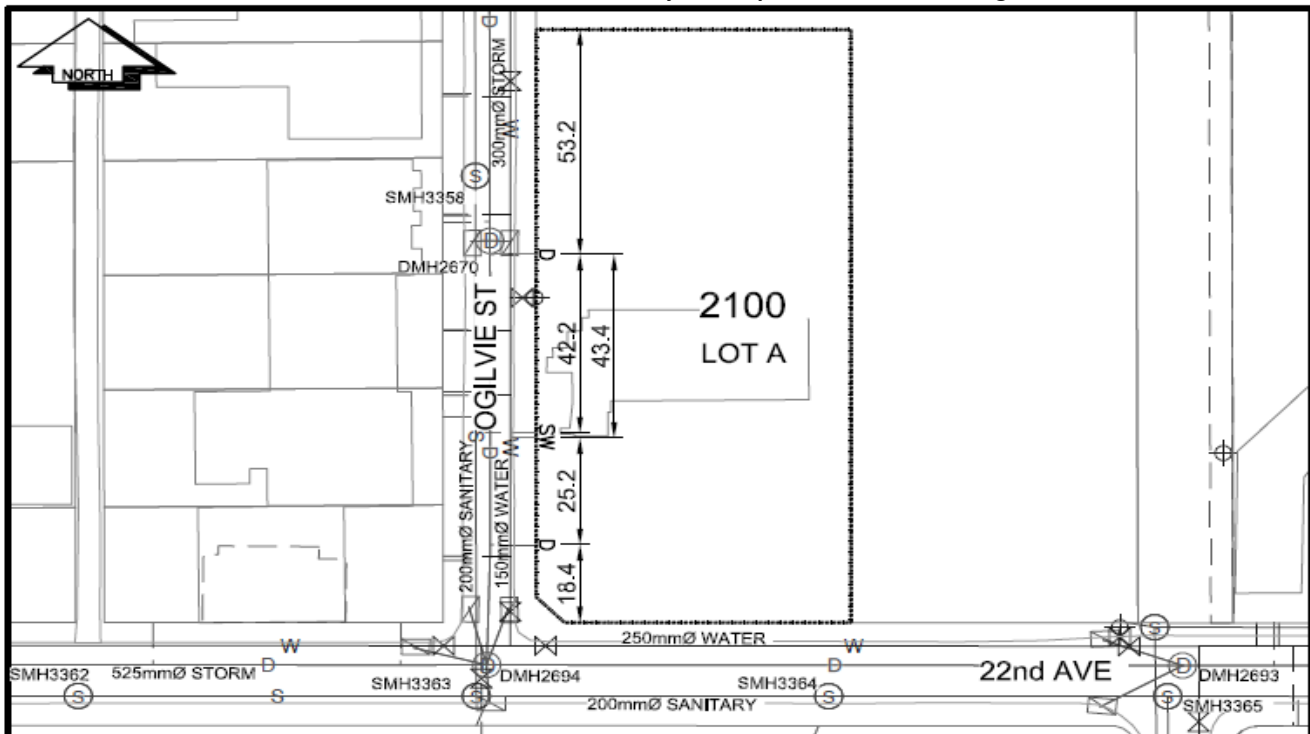

CS ^o	CURB STOP	---	W	WATER SERVICE	---	D	STORM SERVICE
CO	CLEAN OUT	---	S	SANITARY SERVICE	---	G	GAS

NOT TO SCALE