



CITY OF
PRINCE GEORGE

City of Prince George HISTORY SHEET

| | |
|--------|-------------|
| PID: | 017-412-030 |
| SD/MU: | |
| WO: | |

CIVIC ADDRESS: 1404 Patricia Boulevard

LEGAL DESCRIPTION: LOT A, District Lot 343, Cariboo District, Plan PGP35522

| SERVICE TYPE | DIAMETER (mm) | MATERIAL | INVERT ELEV AT MAIN (m) | INVERT ELEV AT PROPERTY LINE (m) | INVERT ELEV AT SERVICE END (m) | COVER AT PROPERTY LINE (m) | DISTANCE INTO PROPERTY (m) | INSTALLATION DATE |
|--------------|---------------|----------|-------------------------|----------------------------------|--------------------------------|----------------------------|----------------------------|-------------------|
| SANITARY | 200 | PVC | 566.55 | - | AT BUILDING | - | - | OCT 2019 |
| WATER | 200 | PVC | 566.07 | - | AT BUILDING | - | - | OCT 2019 |
| STORM | 300 | PVC | 567.63 | aprox. 567.67 | 567.69 | aprox. 1.5m | aprox. 5m | SEP 2020 |

ELECTRICAL / COMMUNICATIONS / GAS

| TYPE | PROVIDER | SIZE AND MATERIAL | LOCATION (UNDERGROUND/ OVERHEAD) |
|---------------|----------|-------------------|-----------------------------------|
| ELECTRICAL | BC HYDRO | 100mm PVC | UNDERGROUND |
| COMMUNICATION | TELUS | 100mm PVC | UNDERGROUND |
| COMMUNICATION | SHAW | 100mm PVC | UNDERGROUND |
| GAS | FORTISBC | UNKNOWN | UNDERGROUND |


INFORMATION SHEETS: FACTION PROJECTS INC.

SURVEY DATE: -

INSTALLED BY: BRANIFF CONSTRUCTION (2010) LTD. DBA FACTION CONSTRUCTION

COMMENTS: NO SPECIFIC SURVEY HAS BEEN PERFORMED TO DETERMINE DISTANCES AND ELEVATIONS. INFORMATION WAS PROVIDED BY PROJECT CONSTRUCTION DRAWINGS AND RECORD DRAWINGS.

THE INFORMATION CONTAINED HEREIN IS FOR INTERNAL USE ONLY.
NOT TO BE RELIED UPON UNLESS CONFIRMED BY SITE INVESTIGATION.

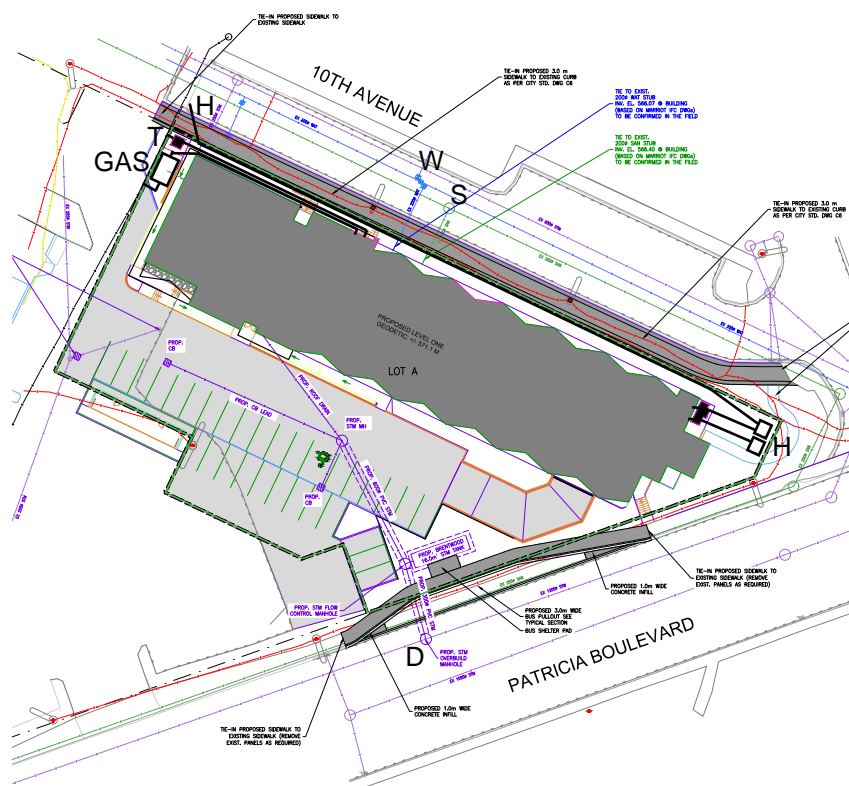

LEGEND:

CS ● CURB STOP
CO ● CLEAN OUT

— W — WATER SERVICE
— S — STORM SERVICE
— S — SANITARY SERVICE

— H — HYDRO SERVICE
— T — TELECOMMUNICATIONS

— GAS — GAS
— UG — SHALLOW UTILITIES