

City of Prince George
HISTORY SHEET

SHEET NUMBER

Roll Number 017474574

Legal: LOT'S 6 BLOCK D.L. 482 PLAN 35622

Address: 4652 HUNTER PLACE

Sanitary Connection: # SIZE 100mm MATERIAL PVC INV. CONNECTED

Water Connection # SIZE 20mm MATERIAL CU METER CONNECTED

Storm Connection: # SIZE MATERIAL INV. CONNECTED

Cash Receipt No's: WATER SANITARY STORM

CURB FROM PROPERTY LINE PAVEMENT WIDTH

B.C. HYDRO UNDERGROUND CONNECTION


B.C. TELEPHONE UNDERGROUND CONNECTION

INLAND GAS

Information Sheets:

Comments:

THE INFORMATION CONTAINED HEREIN IS FOR INTERNAL USE ONLY.
NOT TO BE RELIED UPON UNLESS CONFIRMED BY SITE INSPECTION AND/OR INVESTIGATION

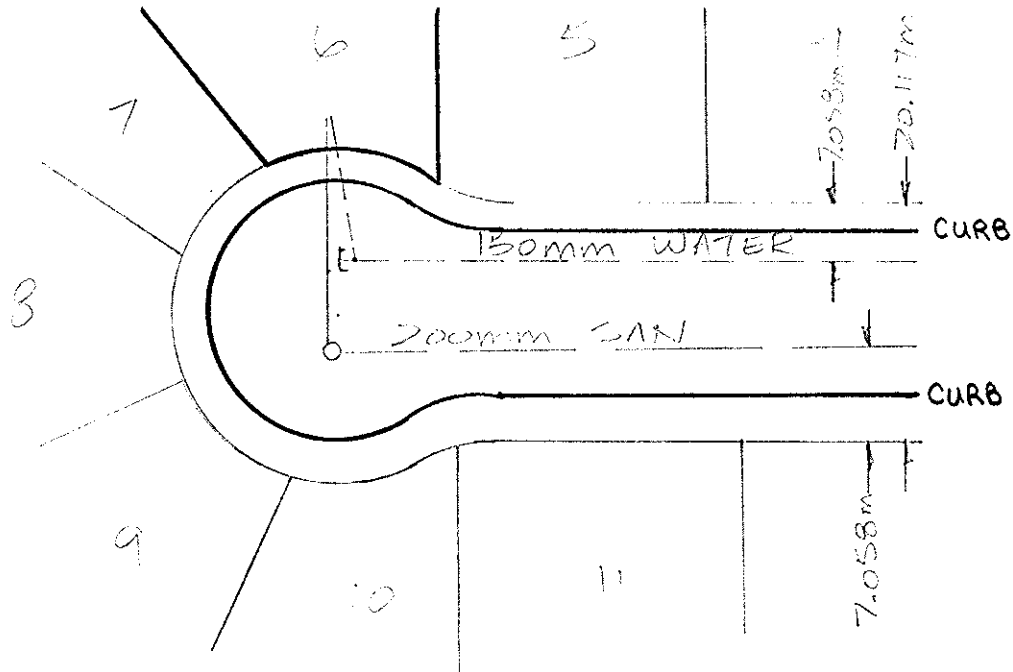

CONNECTIONS COMMON TRENCHED
@ E OF LOT