


Lot Servicing

6565 INDUSTRIAL WAY

PID: 017810299

Lot: 1, Plan: PGP36282, DL: 747

SERVICE	SIZE	MATERIAL	INSTALLED DATE	LOCATION	DETAILS
WATER	25mm	Unknown	Nov 2000	50.0m W 3.0m S JE75A	Receipt 100059 Work Order 00-P029

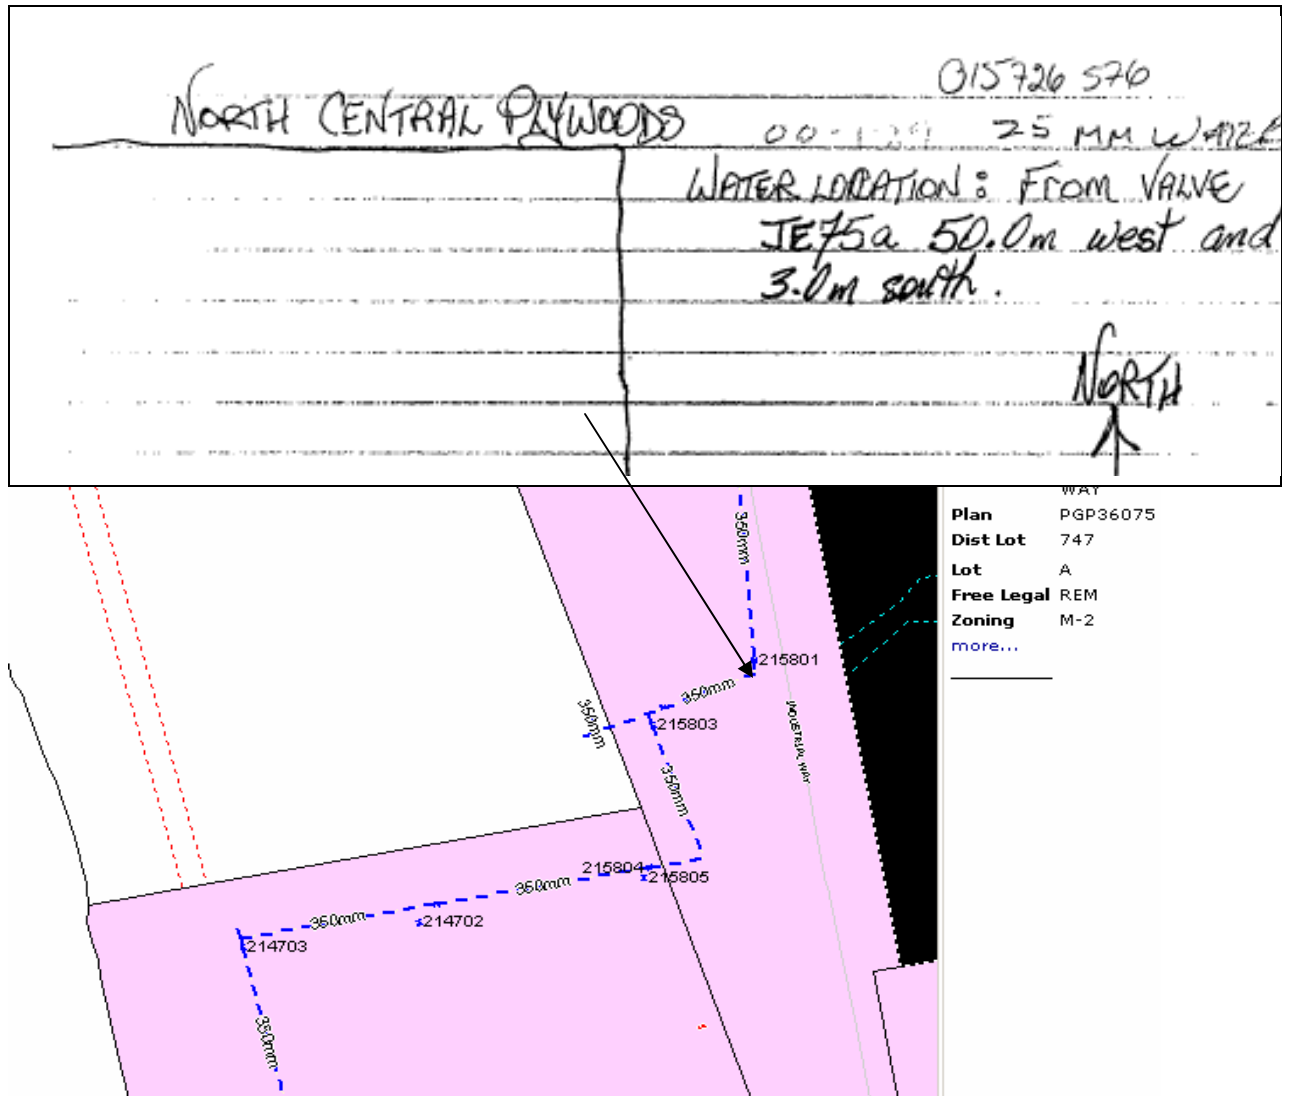

Accuracy not guaranteed unless confirmed by site inspection and/or investigation.
Connection location between main and property line only.