

Lot Servicing

6900 ALDEEN RD

PID: 017877601

Lot: 2, Plan: 31597, DL: 1599

SERVICE	SIZE	MATERIAL	INSTALLED DATE	LOCATION	DETAILS
WATER	20MM	CU		7.2M S N PL	




— Sanitary

- - Storm

- - Water

25 Lot Number

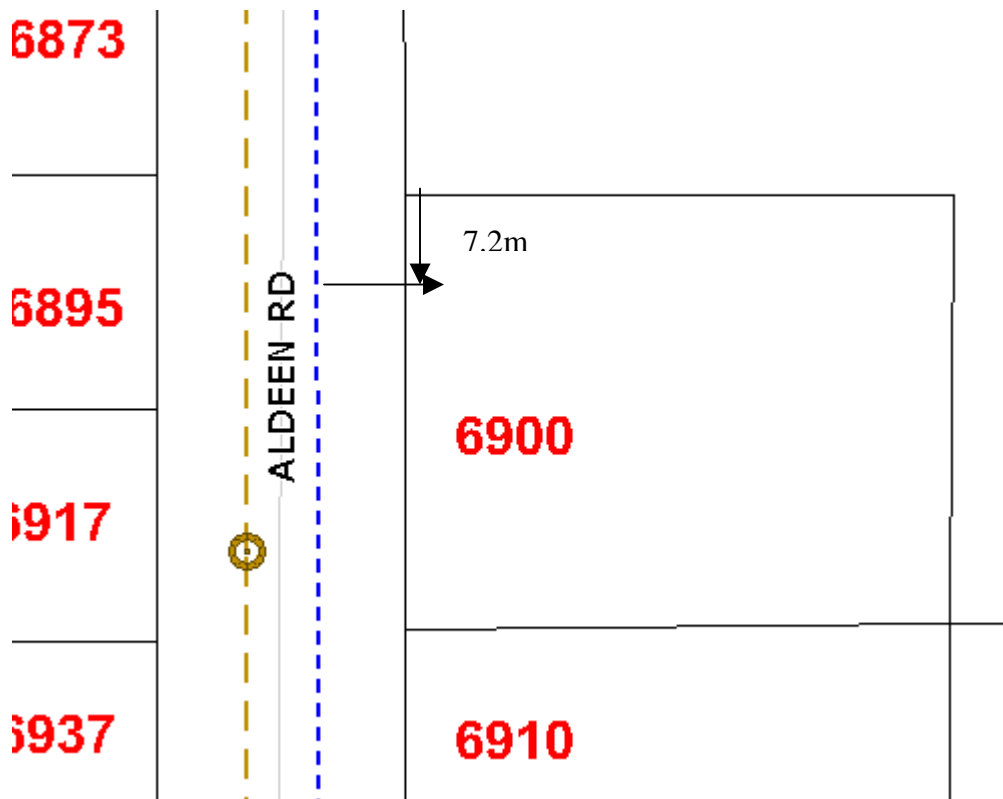

Accuracy not guaranteed unless confirmed by site inspection and/or investigation.
Connection location between main and property line only.

