



City of Prince George  
**History Sheet**

PID:	017886651
SD/MU:	
WO:	

Civic Address: 4288 5th Ave

Legal Description: Lot:A District Lot: 2507 Plan: PGP36482

Service Type	Diameter (mm)	Material	Invert Elev at Main (m)	Invert Elev at Property Line(m)	Invert Elev at Service End (m)	Distance into Property (m)	Installation Date
Sanitary	200mm	AC					January, 1973
Water	150mm	AC					January, 1974
Storm	375mm	CONC					January, 1973

**Service Connection Location**

200mm Sanitary Service connected to San MH2555


375mm Storm Service connected to Stm MH382

Power	Size	Communications	Size	Cable	Size	Gas	Size
BC Hydro		Telus		Shaw		Fortis BC	
Underground Service		Underground Service		Underground Service			

**Installed by:**

Comments: Sanitary, Water and Storm services to 448 Tabor Blvd through easements on Lot A

NOT TO SCALE The information contained herein is for internal use only.  
Not to be relied on unless confirmed by the site inspection and/or investigation.

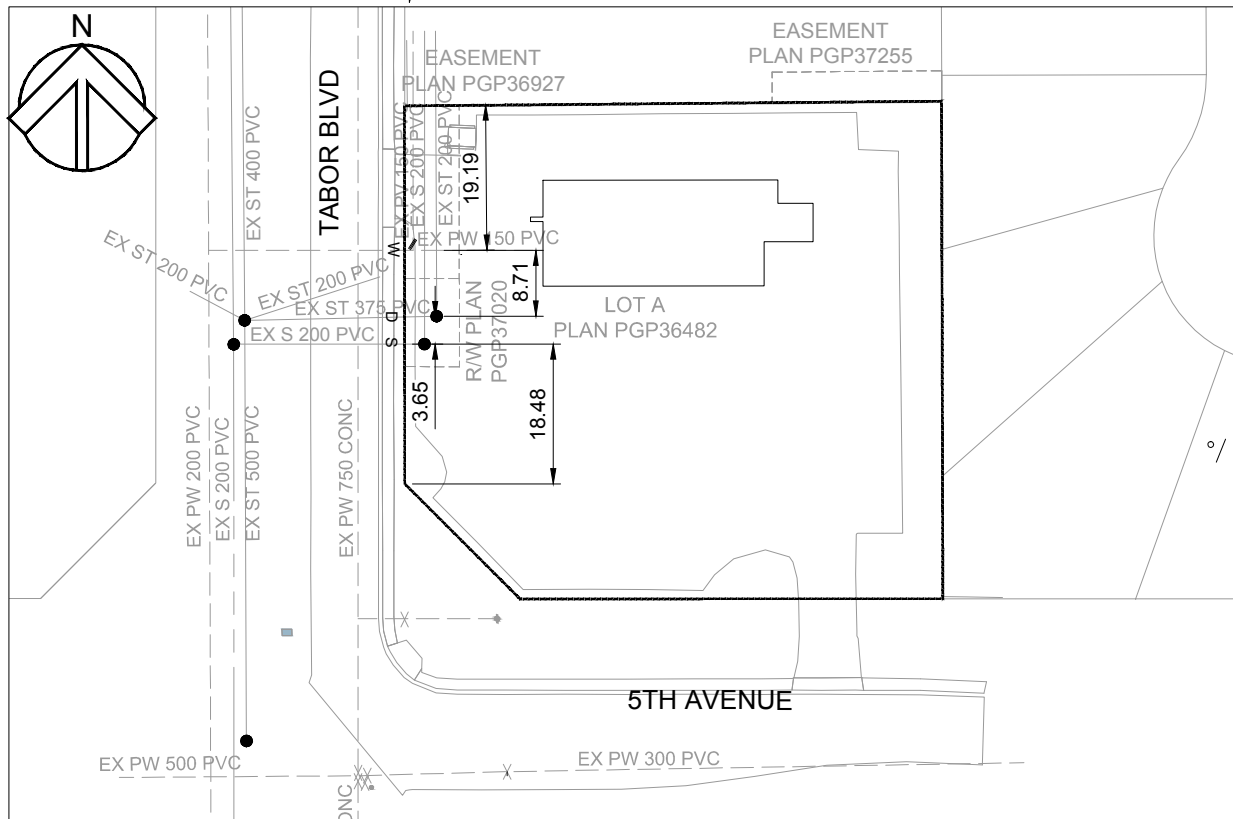

CS CURB STOP	WATER SERVICE	STORM SERVICE
CO CLEAN OUT	SANITARY SERVICE	GAS
WATER VALVE	FIRE HYDRANT	ENCUMBRANCE