

City of Prince George
HISTORY SHEET

SHEET NUMBER **5783** Roll Number **08088074**

Legal: LOT'S **63 5** BLOCK **4048** D.L. **2023** PLAN **36894**

Address: **4706 STABLE Rd.** **BUSSE ROAD.**

Sanitary Connection: # SIZE **100 mm** MATERIAL **PVC** INV. **91.73** CONNECTED

Water Connection # SIZE **18 mm** MATERIAL **COPPER** METER CONNECTED

Storm Connection: # SIZE MATERIAL INV. CONNECTED

Cash Receipt No's: WATER SANITARY STORM

CURB FROM PROPERTY LINE **5" (ROLL CURB)** PAVEMENT WIDTH **10"**

B.C. HYDRO UNDERGROUND CONNECTION

B.C. TELEPHONE UNDERGROUND CONNECTION

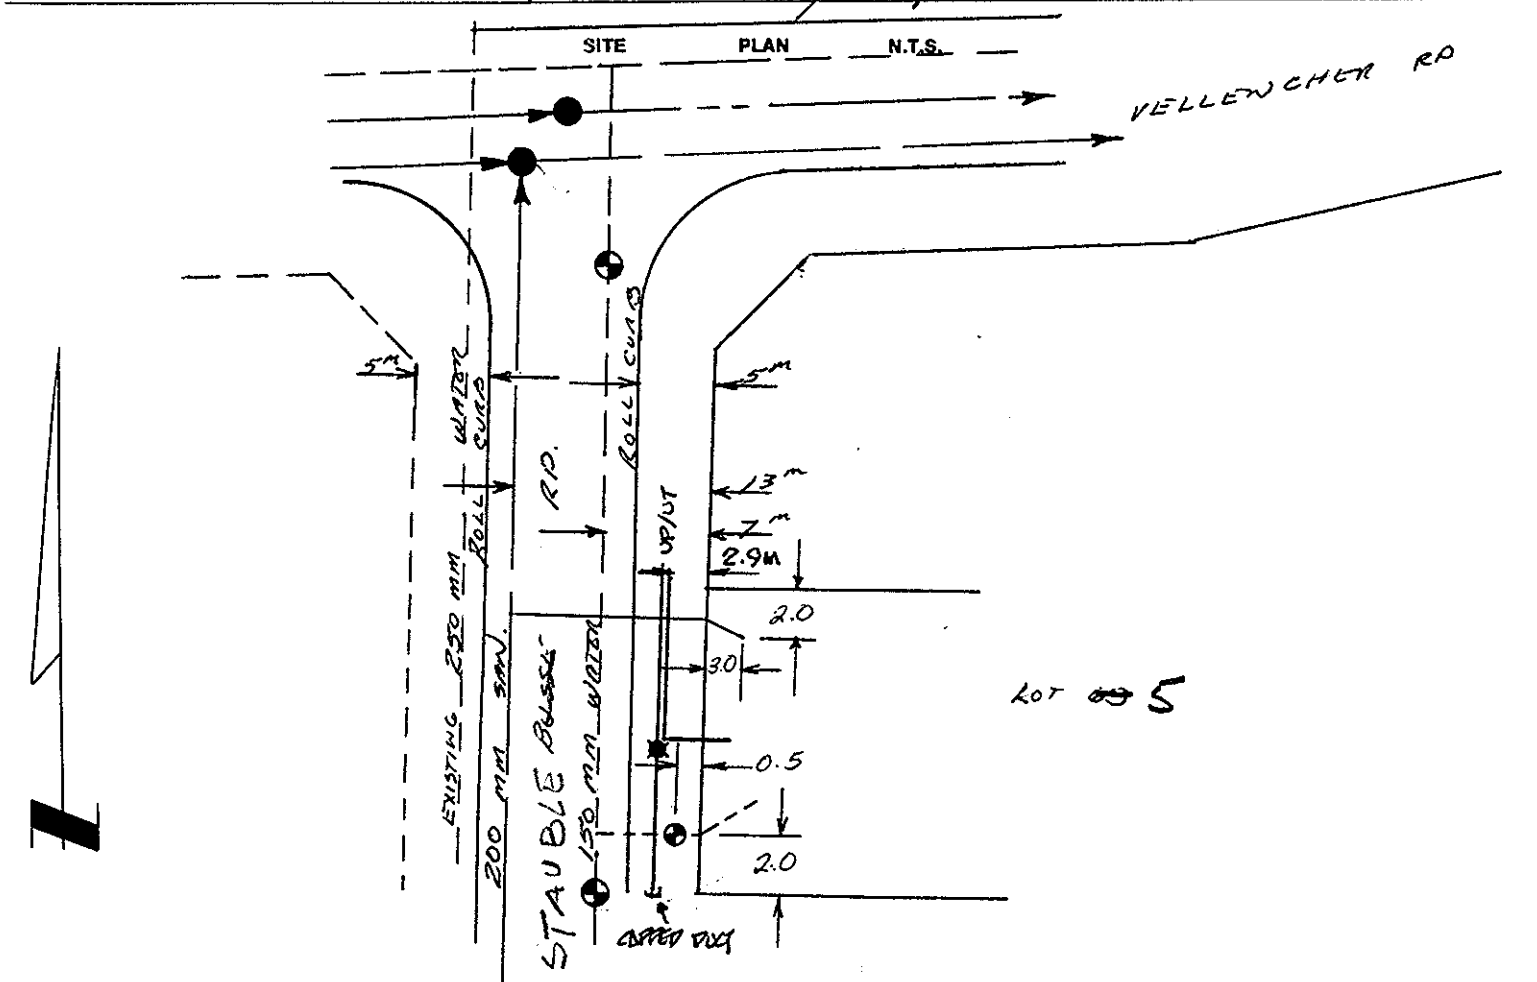
INLAND GAS

Information Sheets:

Comments: **BENCH MARK: #1969 - ELEV 777.186M**

TOP F.H. SPIN S/W COR HIGHLAND

1 MONTGOMERY W/LEG



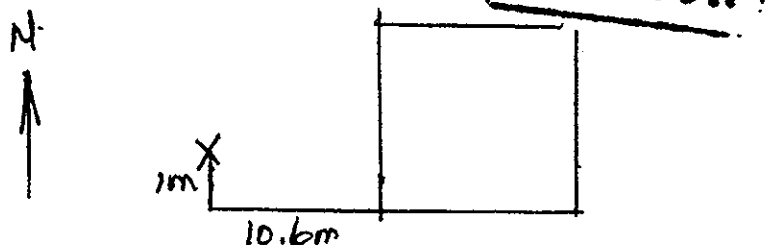
REPORT TO RECORDS

WATER SERVICE INFORMATION

Lot No. _____ Block _____ D.L. _____

Address 4706 STAUBLE RD.Size of Connection ☐ 1/2" ☒ 3/4" ☐ Other _____Type of Connection ☒ Copper ☐ IronThaw Wire ☒ Yes ☐ No

LOCATION SKETCH

Field Location By L. Punks Date April 25/95

Checked by: _____

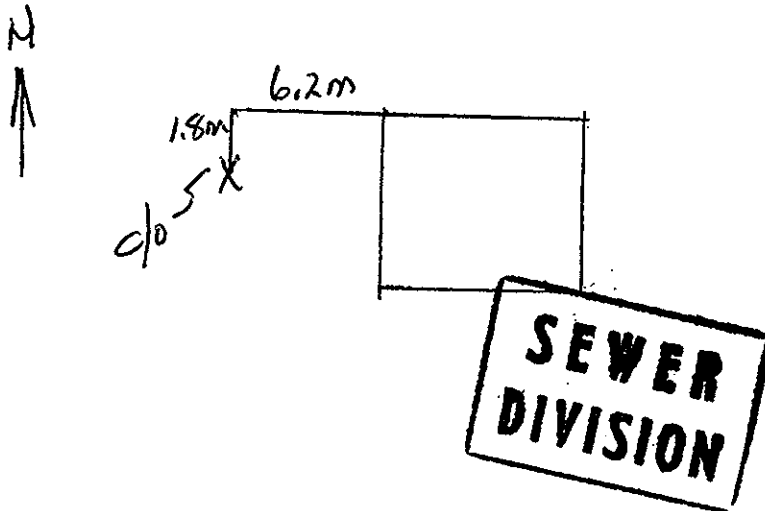
REPORT TO RECORDS

SEWER SERVICE INFORMATION

Lot No. _____ Block _____ D.L. _____

Address 4706 STABLE RDSize of Connection ☒ 100mm ☐ 150mm ☐ 200mm ☐ Other _____Type of Connection ☐ Transite ☒ PVC ☐ Other _____Type of Cap ☐ Transite ☒ Cast Iron

LOCATION SKETCH

Field Location By L. Panko. Date April 25/95

Checked by Foreman - Sewer Division _____