

City of Prince George HISTORY SHEET

ASSOCIATED SERVICES LTD.
301 - 17. AVENUE
PRINCE GEORGE, B.C. V2L 3G7

SHEET NUMBER **Nº 3114** Roll Number **018154 930**

Legal: LOT'S **D** BLOCK **D.L. 4049** PLAN **36951**

Address: **4461 STABLE ROAD**

Sanitary Connection: # SIZE **100mm** MATERIAL **PVC** INV. **779.88** CONNECTED

Water Connection # SIZE **19mm** MATERIAL **COPPER** METER CONNECTED

Storm Connection: # SIZE MATERIAL INV. CONNECTED

Cash Receipt No's: WATER SANITARY STORM

CURB FROM PROPERTY LINE **ROLL CURB 5.0 M** PAVEMENT WIDTH **10.0 M**

B.C. HYDRO UNDERGROUND CONNECTION

B.C. TELEPHONE UNDERGROUND CONNECTION


INLAND GAS

Information Sheets:

Comments: **CITY BM #1969-79 ELEV. 777.168** **1/4 SP. SW. CORNER HIGHLAND &**

MONTGOMERY. WEST LEG.

THE INFORMATION CONTAINED HEREIN IS FOR INTERNAL
USE ONLY. NOT TO BE RELIED UPON UNLESS CONFIRMED
BY SITE INSPECTION AND/OR INVESTIGATION.

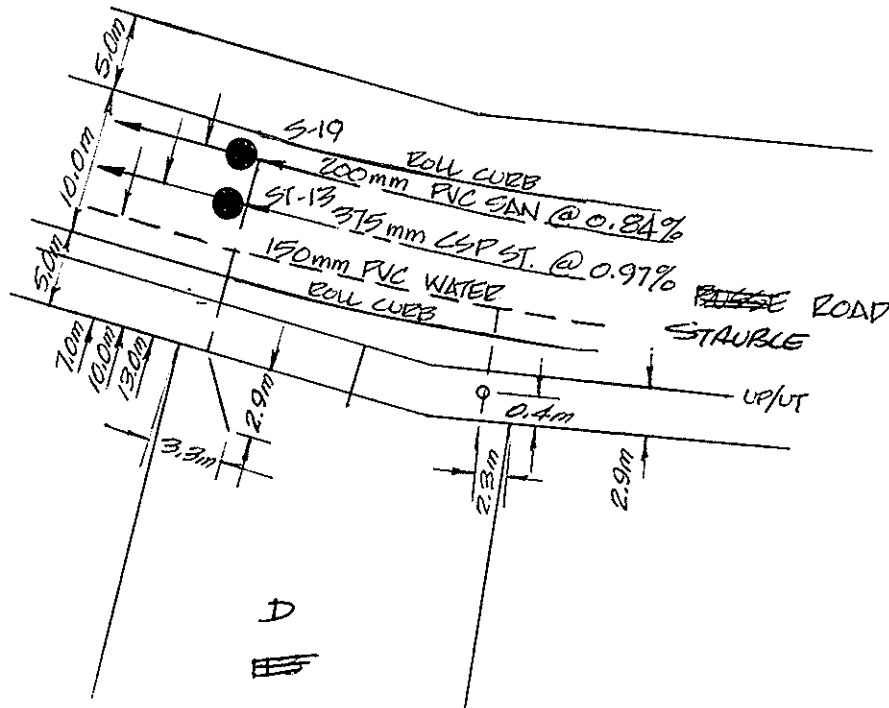

D

1042
1054