
City of Prince George HISTORY SHEET

018/8/6/9

SHEET NUMBER		Roll Number		
Legal: LOT'S 7	BLOCK	d.l. 2611		plan 37043
Address: 3726 GOHEEN	PLACE			
Sanitary Connection: #	size (W)mm	MATERIAL PVC	INV.	CONNECTED
Water Connection #	SIZE WHM	MATERIAL COPPER	METER	CONNECTED
Storm Connection: #	SIZE	MATERIAL	INV.	CONNECTED
Cash Receipt No's: WATER		SANITARY		STORM .
CURB FROM PROPERTY LINE	PAVEMENT WIDTH			
B.C. HYDRO	UNDERGROUND CONNECTION			
B.C. TELEPHONE	UNDERGROUND CONNECTION			
INLAND GAS				
Information Sheets:				
Comments:				

THE INFORMATION CONTAINED HEREIN IS FOR INTERNAL USE ONLY.

NOT TO BE RELIED UPON UNLESS CONFIRMED BY SITE INSPECTION AND/OR INVESTIGATION

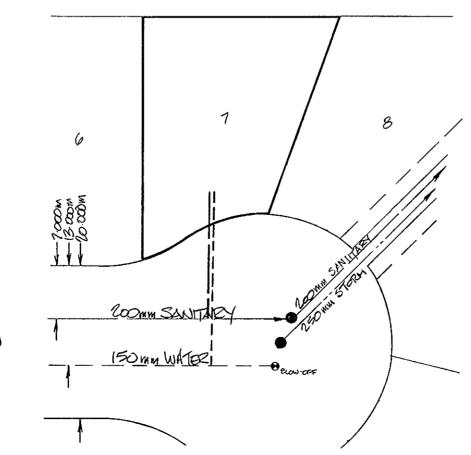

GOHER