



City of Prince George

History Sheet

PID:	018266932
	016121791
SD/MU:	
WO:	

Civic Address: 901 955 1st Ave

Legal Description: Lot: PCL A District Lot: 343 Plan: PGP37186

Lot: A District Lot: 343 Plan: 6287


Service Type	Diameter (mm)	Material	Invert Elev at main (m)	Invert Elev at property line (m)	Invert Elev at service end (m)	Distance into property (m)	Installation Date
Sanitary	150mm	AC	-	-	-	-	January 1979
Water (W1)	Unknown	Unknown	-	-	-	-	January 1966
Water (W2)	Unknown	Unknown	-	-	-	-	January 1966
Water (W3)	100mm	Cast Iron					January 1966
Water (W4)	100mm	Cast Iron					January 1966
Water (W5)	Unknown	Unknown					January 1966
Storm	250mm	PVC	-	567.29	-	-	January 1962

Service Connection Location	Sanitary (m)	Storm (m)
Sanitary service connected to San MH2014	-	
Distance from downstream Stm MH - towards upstream Stm MH -		

Power	Size	Communications	Size	Cable	Size	Gas	Size
BC Hydro	-	Telus	-	Shaw	-	FortisBC	-
Overhead Service		Overhead Service		Overhead Service			

Installed by:	Survey Date:	-
Comments:		

NOT TO SCALE The information contained herein is for internal use only.
Not to be relied on unless confirmed by site inspection and/or investigation.

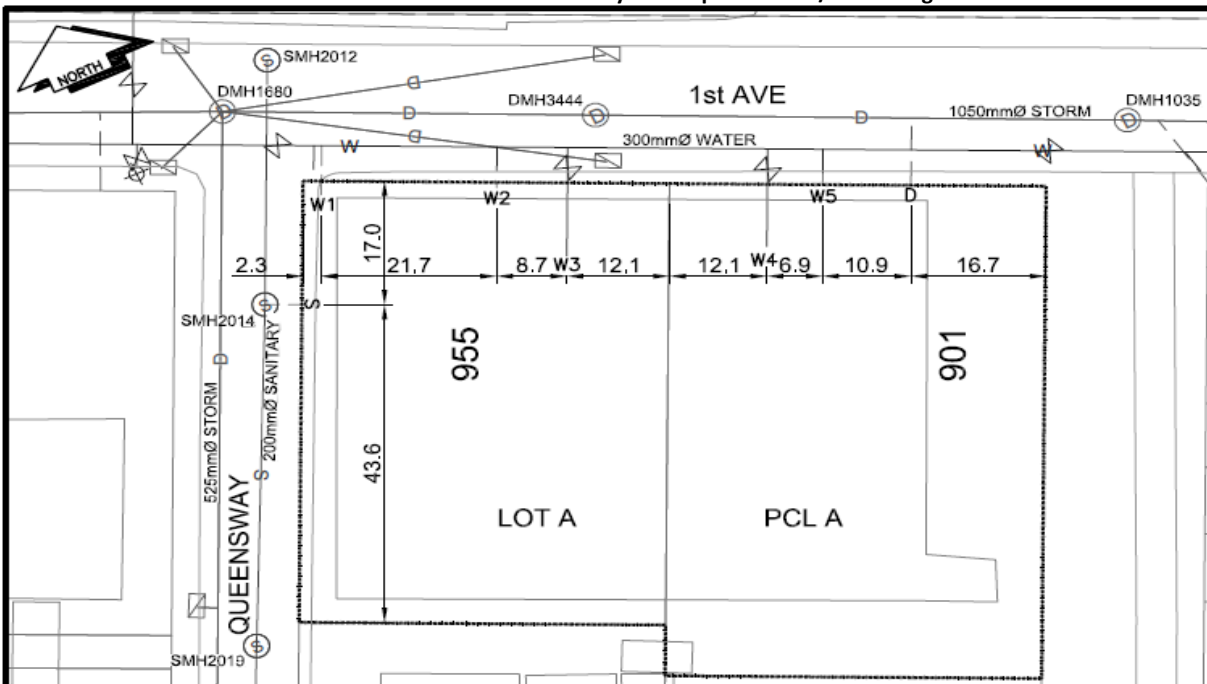

LEGEND:	CURB STOP	WATER SERVICE	STORM SERVICE
	CLEAN OUT	SANITARY SERVICE	GAS
	WATER VALVE	FIRE HYDRANT	ENCUMBRANCE

NOT TO SCALE