



City of Prince George History Sheet

PID:	018283241
SD/MU:	
WO:	

Civic Address: 2027 Skyline Dr

Legal Description: Lot: PCL A District Lot: 4377 Plan: PGP37231


Service Type	Diameter (mm)	Material	Invert Elev at main (m)	Invert Elev at property line (m)	Invert Depth at service end (m)	Distance into property (m)	Installation Date
Sanitary (S1)	100mm	PVC	-	-	-	-	January 1978
Sanitary (S2)	100mm	PVC	-	-	4.00	-	January 1978
Water (W1)	20mm	Copper	-	-	-	-	January 1972
Water (W2)	40mm	Copper	-	-	-	-	May 1994
Storm	N/A	N/A	-	-	-	-	

Service Connection Location				Sanitary (m)	Storm (m)
Distance from downstream San MH	1570	towards upstream San MH	1594	35.20	
Distance from downstream San MH	1594	towards upstream San MH	1596	19.50	

Power	Size	Communications	Size	Cable	Size	Gas	Size
BC Hydro	-	Telus	-	Shaw	-	FortisBC	-
Overhead Service		Overhead Service		Overhead Service			

Installed by:		Survey Date:	-
Comments:	Water and Sanitary services location confirmed March 2017.		

NOT TO SCALE The information contained herein is for internal use only.
Not to be relied on unless confirmed by site inspection and/or investigation.

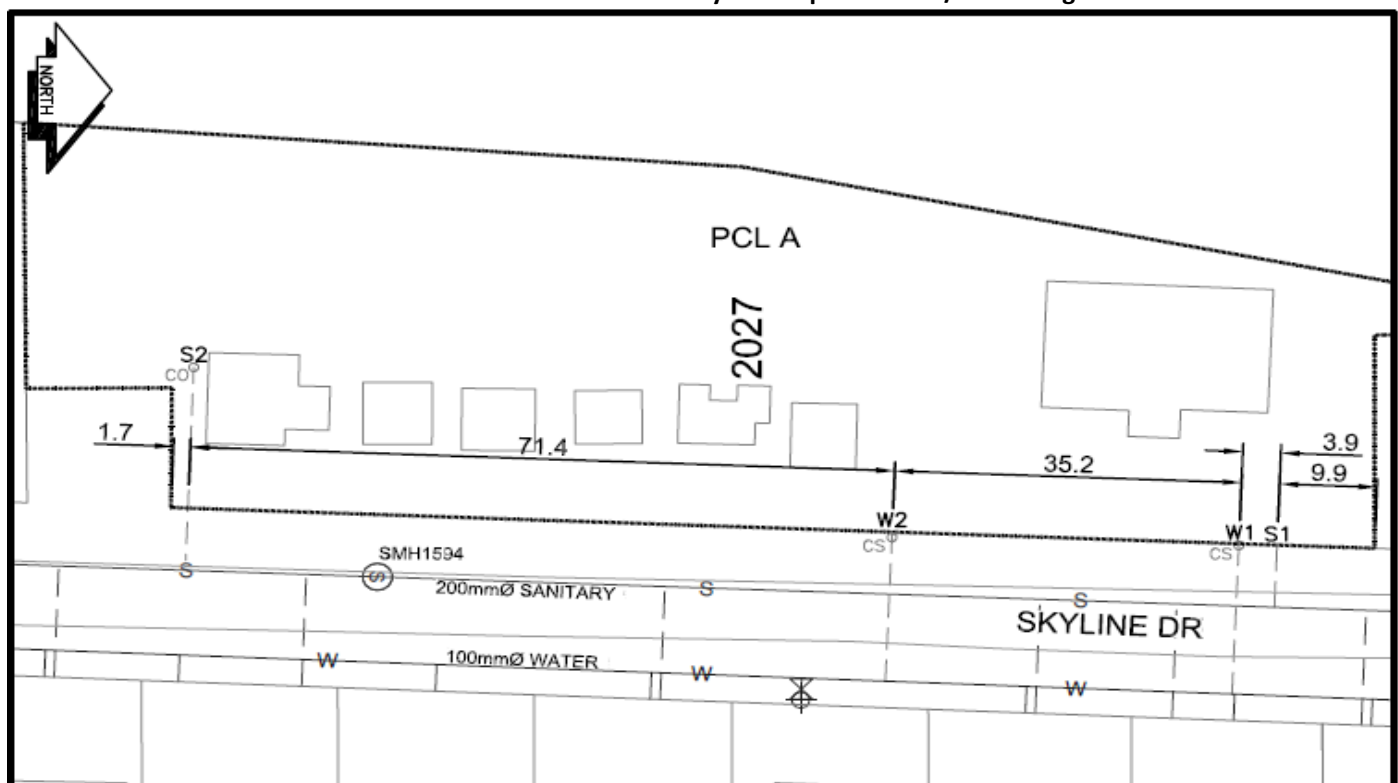

CS ^o CURB STOP	--- WATER SERVICE	--- STORM SERVICE
CO ^o CLEAN OUT	--- SANITARY SERVICE	--- GAS
⊗ WATER VALVE	⊗ FIRE HYDRANT	--- ENCUMBERANCE

NOT TO SCALE