



City of Prince George History Sheet

PID:	018325041
SD/MU:	
WO:	

Civic Address: 353 Blackburn Road

Legal Description: Lot: A District Lot: 954 Plan: PGP37302


Service Type	Diameter (mm)	Material	Invert Elev at main (m)	Invert Elev at property line (m)	Invert Elev at service end (m)	Distance into property (m)	Installation Date
Sanitary	100mm	PVC	-	-	-	-	January 1976
Water	50mm	Copper	-	-	-	-	January 1970
Storm	N/A	N/A	-	-	-	-	

Service Connection Location					Sanitary (m)	Storm (m)
Distance from downstream San MH	2023	towards upstream San MH	1885		33.68	
Distance from downstream Stm MH	-	towards upstream Stm MH	-			

Power	Size	Communications	Size	Cable	Size	Gas	Size
BC Hydro	-	Telus	-	Shaw	-	FortisBC	-
Overhead Service		Overhead Service		Overhead Service			

Installed by:	Survey Date:	-
Comments:		

NOT TO SCALE The information contained herein is for internal use only.
Not to be relied on unless confirmed by site inspection and/or investigation.

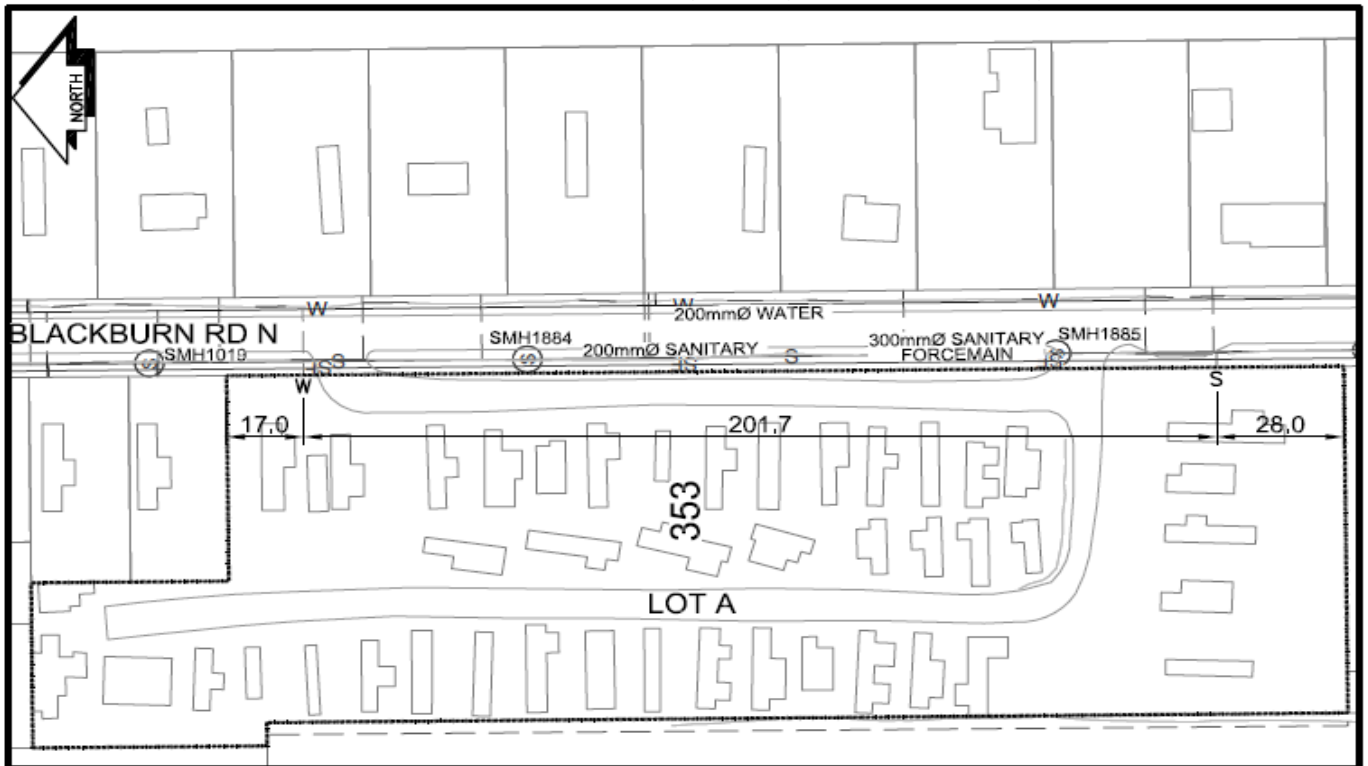

CS ^o CURB STOP	--- W WATER SERVICE	--- S STORM SERVICE
CO ^o CLEAN OUT	--- S SANITARY SERVICE	--- G GAS
WV WATER VALVE	--- FH FIRE HYDRANT	--- ENCUMBRANCE

NOT TO SCALE