

City of Prince George HISTORY SHEET

SHEET NUMBER

Roll Number **018325050**

Legal: LOT'S **P1B** BLOCK D.L. **954** PLAN **37302**

Address: **301 BLACKBURN RD**

Sanitary Connection: # SIZE **100 mm** MATERIAL INV. CONNECTED

Water Connection # SIZE **20 mm** MATERIAL METER CONNECTED

Storm Connection: # SIZE MATERIAL INV. CONNECTED

Cash Receipt No's: WATER SANITARY STORM

CURB FROM PROPERTY LINE PAVEMENT WIDTH

B.C. HYDRO **0/H** UNDERGROUND CONNECTION


B.C. TELEPHONE **0/H** UNDERGROUND CONNECTION

INLAND GAS **AS SHOWN**

Information Sheets:

Comments:

**THE INFORMATION CONTAINED HEREIN IS FOR INTERNAL USE ONLY.
NOT TO BE RELIED UPON UNLESS CONFIRMED BY SITE INSPECTION AND/OR INVESTIGATION**

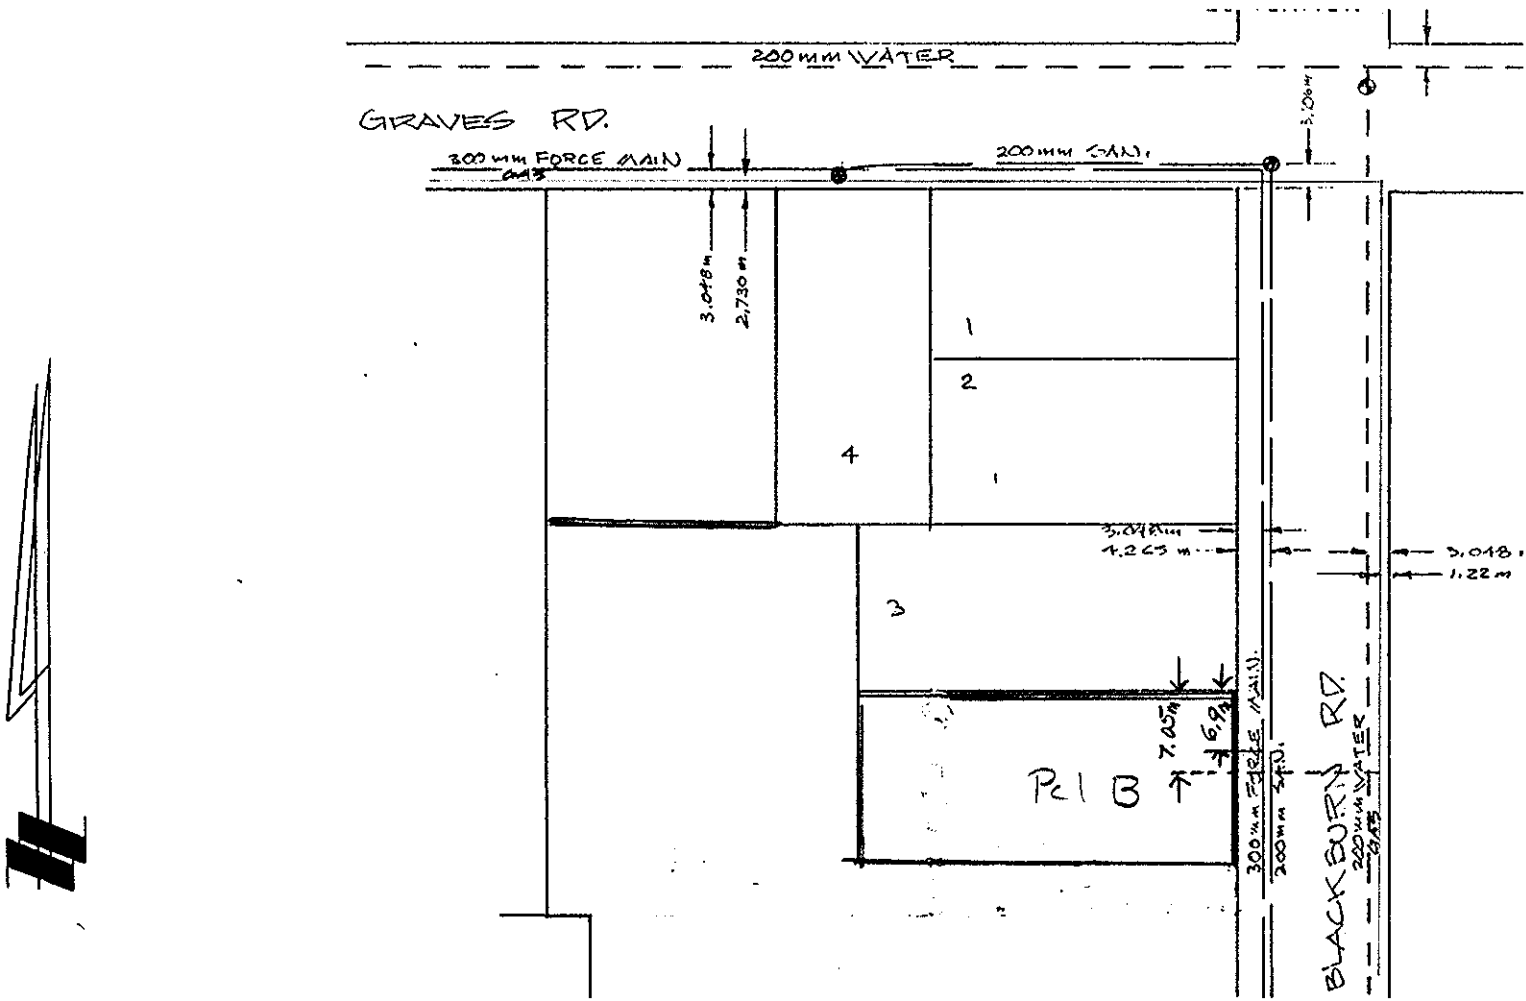

REPORT TO RECORDS

WATER SERVICE INFORMATION

Lot No. _____ Block _____ D.L. _____

Address 301 N. BLACKBURNSize of Connection ☐ 1/2" ☒ 3/4" ☐ Other _____Type of Connection ☒ Copper ☐ IronThaw Wire ☐ Yes ☐ No

LOCATION SKETCH

N
4

WATER SERVICE



● 7.05 S OF N.

(SEWER)
(WATER)Field Location By KQ Date JULY 12TH - 01

Checked by: _____

CITY PUBLIC WORKS DEPT 018325050-S
REPORT TO RECORDS
SEWER SERVICE INFORMATION

Lot No. _____ Block _____ D.L. _____


Address 301. N. BLACKBURN

Size of Connection ☒ 100mm ☐ 150mm ☐ 200mm ☐ Other _____

Type of Connection ☐ Transite ☒ PVC ☐ Other _____

Type of Cap ☐ Transite ☒ Cast Iron

LOCATION SKETCH

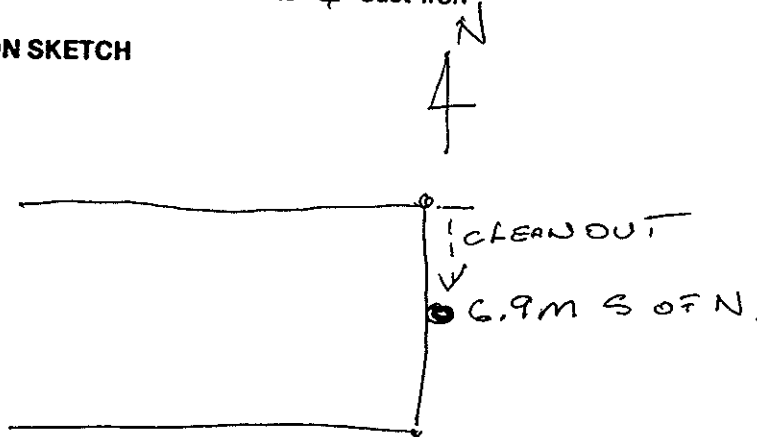

Field Location By R.S. Date JULY 12TH 01

Checked by Foreman - Sewer Division _____