

City of Prince George
HISTORY SHEET

SHEET NUMBER

Roll Number

018480040

Legal:

LOT'S

2

BLOCK

D.L.

2003

PLAN

37499

Address:

4500 WHEELER ROAD

Sanitary Connection: #

SIZE

100 mm

MATERIAL

P.V.C.

INV.

CONNECTED

Water Connection #

SIZE

20 mm

MATERIAL

CU

METER

CONNECTED

Storm Connection: #

SIZE

100 mm

MATERIAL

P.V.C.

INV.

CONNECTED

Cash Receipt No's:

WATER

SANITARY

STORM

CURB FROM PROPERTY LINE

5,000 m

PAVEMENT WIDTH

10,000 m

B.C. HYDRO

U/G

UNDERGROUND CONNECTION

B.C. TELEPHONE

U/G

UNDERGROUND CONNECTION

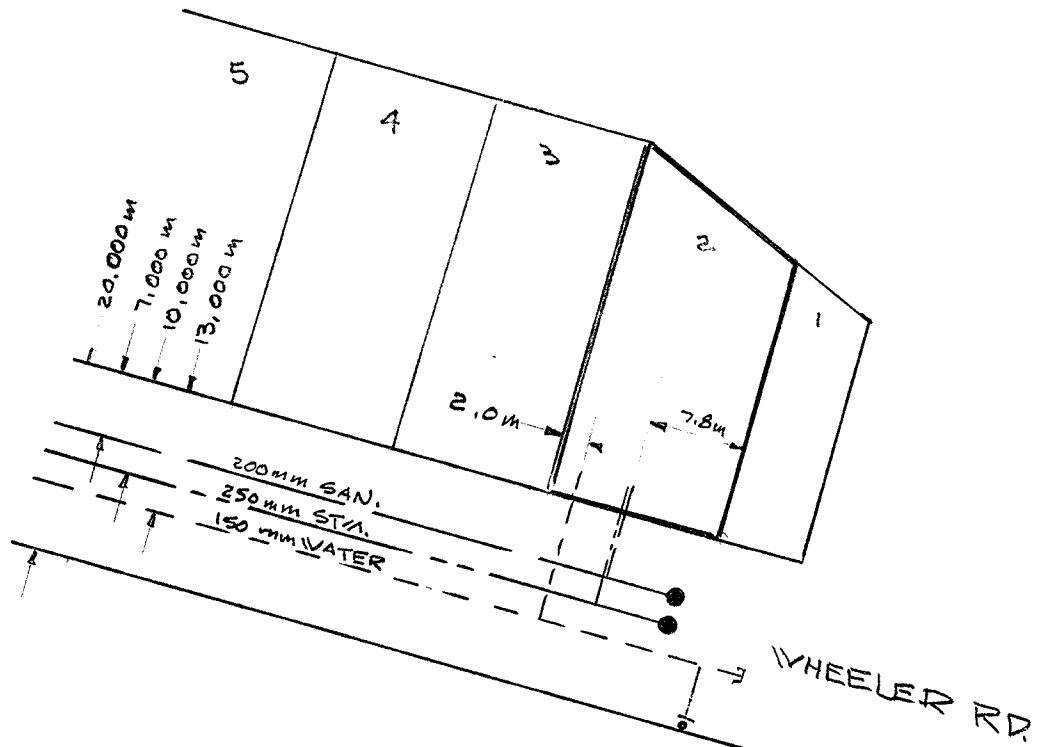
INLAND GAS

THE INFORMATION CONTAINED HEREIN IS FOR INTERNAL
USE ONLY. NOT TO BE RELIED UPON UNLESS CONFIRMED
BY SITE INSPECTION AND/OR INVESTIGATION.

Information Sheets:

Comments:

THE INFORMATION CONTAINED HEREIN IS FOR INTERNAL USE ONLY.
NOT TO BE RELIED UPON UNLESS CONFIRMED BY SITE INSPECTION AND/OR INVESTIGATION



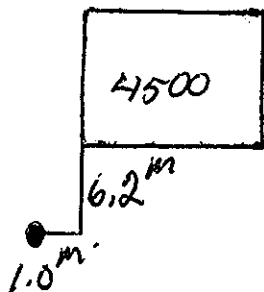
G18420940

REPORT TO RECORDS

WATER SERVICE INFORMATION

Lot No. 2 / 2003/37499 Block 2 D.L. Address 4500 WHEELER RD.Size of Connection ☐ 1/2" ☒ 3/4" ☐ Other Type of Connection ☐ Copper ☐ Iron ☒ PLASTICThaw Wire ☒ Yes ☐ No

LOCATION SKETCH

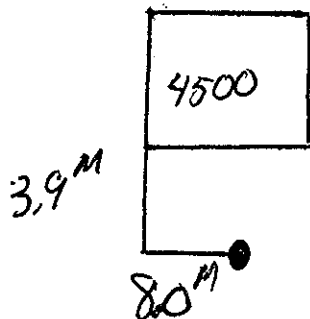
A
mWHEELER RDField Location By Marcus [Signature] Date SEPT 11/95Checked by:

REPORT TO RECORDS

SEWER SERVICE INFORMATION

Lot No. 2 / 2003/37499 Block _____ D.L. _____Address 4500 WHEELER RDSize of Connection ☐ 100mm ☐ 150mm ☐ 200mm ☐ Other _____Type of Connection ☐ Transite ☒ PVC ☐ Other _____Type of Cap ☐ Transite ☒ Cast Iron

LOCATION SKETCH

WHEELER RDField Location By Manuel P. ... Date SEPT. 11/95

Checked by Foreman - Sewer Division _____