



City of Prince George History Sheet

PID:	018441572
SD/MU:	
WO:	

Civic Address: 3349 Seton Cres

Legal Description: Lot: 17 District Lot: 4047 Plan: PGP37520


Service Type	Diameter (mm)	Material	Invert Elev at main (m)	Invert Elev at property line (m)	Invert Depth at service end (m)	Distance into property (m)	Installation Date
Sanitary	100mm	PVC	-	730.10	2.40	-	December 1980
Water	20mm	Copper	-	729.54	-	-	December 1980
Storm	100mm	PVC	-	730.10	2.40	-	December 1980

Service Connection Location				Sanitary (m)	Storm (m)
Distance from downstream San MH	451	towards upstream San MH	450	58.71	
Distance from downstream Stm MH	953	towards upstream Stm MH	954		56.91

Power	Size	Communications	Size	Cable	Size	Gas	Size
BC Hydro	-	Telus	-	Shaw	-	FortisBC	-
Underground Service		Underground Service		Underground Service			

Installed by:	Survey Date:	-
Comments:		

NOT TO SCALE The information contained herein is for internal use only.
Not to be relied on unless confirmed by site inspection and/or investigation.

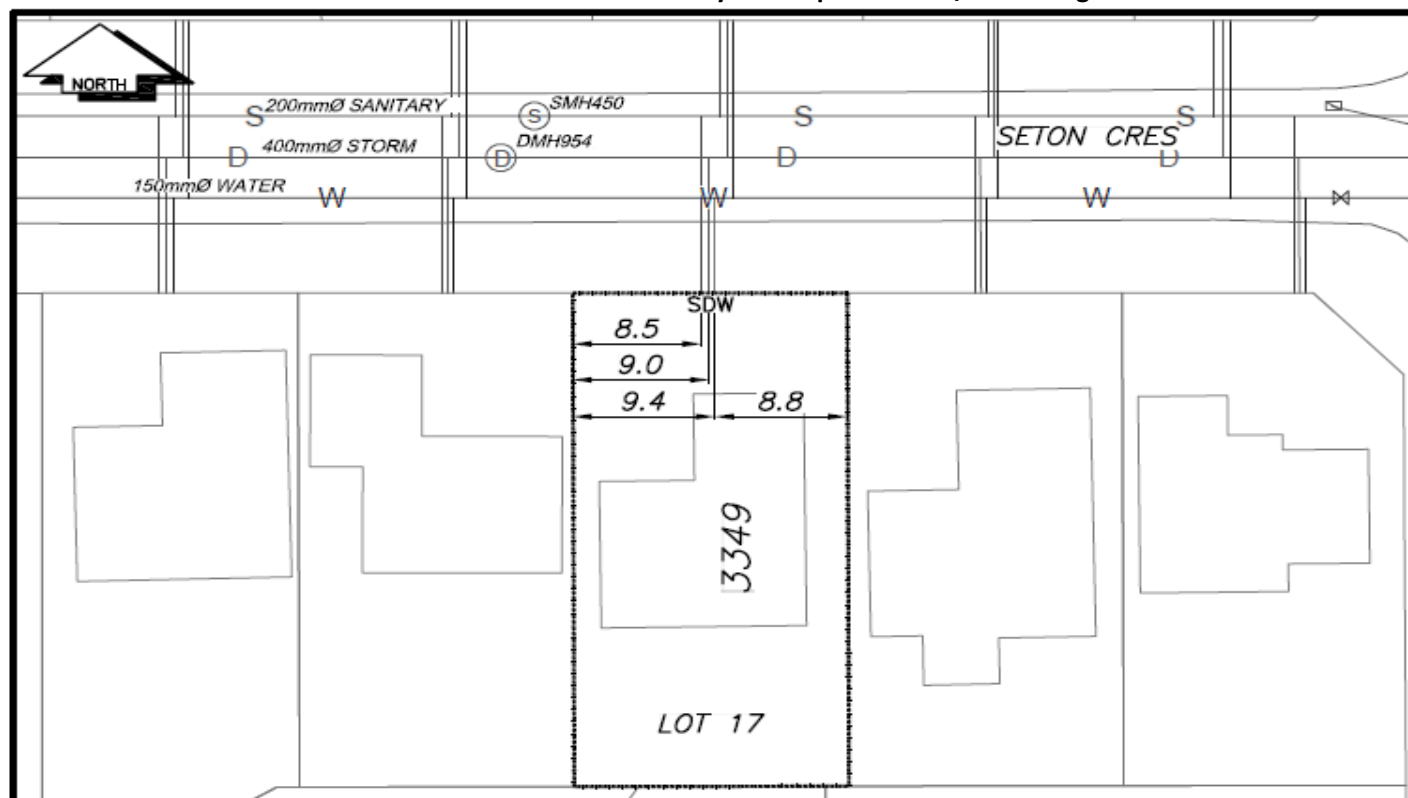

CS ^o CURB STOP	— — — — — WATER SERVICE	— — — — — STORM SERVICE
CO ^o CLEAN OUT	— — — — — SANITARY SERVICE	— — — — — GAS
⊗ WATER VALVE	⊗ FIRE HYDRANT	— — — — — ENCUMBRANCE

NOT TO SCALE