

SHEET NUMBER _____ Roll Number 018511813

Address: 5535 Heyer Road

Storm Connection: # SIZE 100 MATERIAL PVC INV. 728.788 CONNECTED

CURB FROM PROPERTY LINE 5.0m PAVEMENT WIDTH 10.0m

B.C. HYDRO U.C. UNDERGROUND CONNECTION

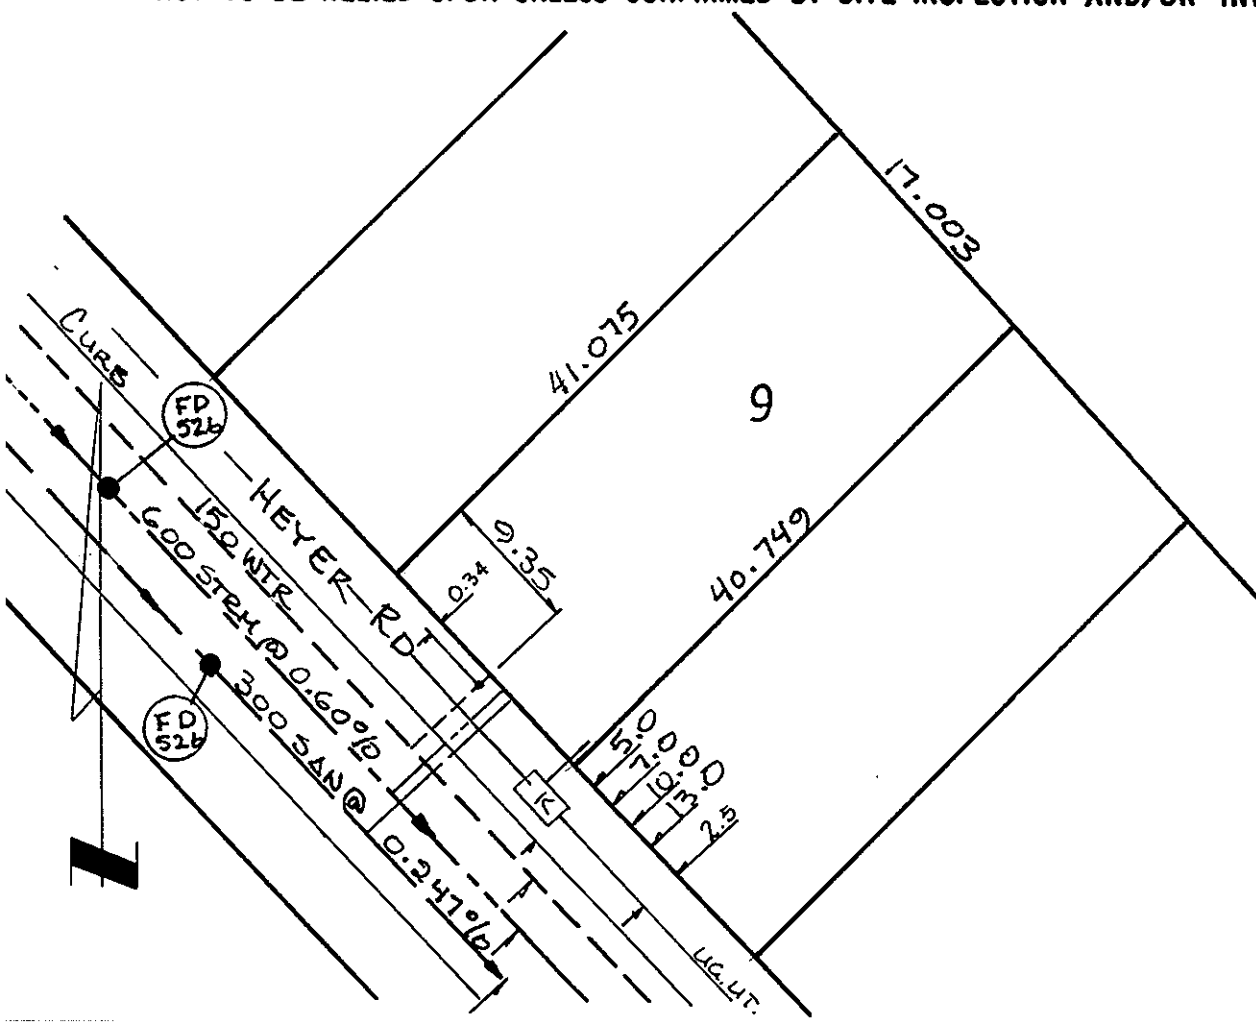
B.C. TELEPHONE U.C. UNDERGROUND CONNECTION

INLAND GAS 60 mm on HEYER RD, 1.5 m From P.L.

Information Sheets:

Comments:

THE INFORMATION CONTAINED HEREIN IS FOR INTERNAL USE ONLY.
NOT TO BE RELIED UPON UNLESS CONFIRMED BY SITE INSPECTION AND/OR INVESTIGATION



018511813

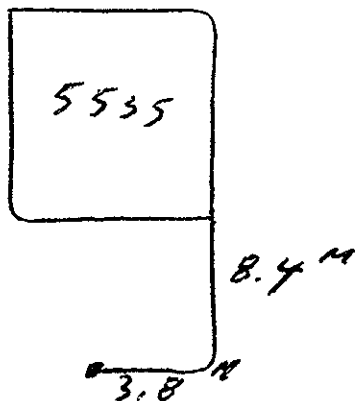
REPORT TO RECORDS

WATER SERVICE INFORMATION

Lot No. _____ Block _____ D.L. _____

Address 5535 MEYER.Size of Connection ☐ 1/2" ☒ 3/4" ☐ Other _____Type of Connection ☐ Copper ☐ IronThaw Wire ☒ Yes ☐ No

LOCATION SKETCH

MEYER.Field Location By Alamir St. Croix Date MARCH 18/96.

Checked by: _____

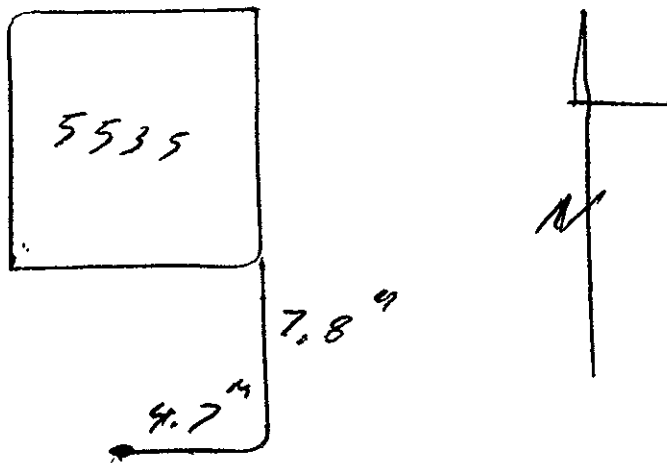
REPORT TO RECORDS

SEWER SERVICE INFORMATION

Lot No. _____ Block _____ D.L. _____

Address 5535 MEYERSize of Connection ☒ 100mm ☐ 150mm ☐ 200mm ☐ Other _____Type of Connection ☐ Transite ☒ PVC ☐ Other _____Type of Cap ☐ Transite ☒ Cast Iron

LOCATION SKETCH

MEYERField Location By Alan J. Cech Date MARCH 18/96

Checked by Foreman - Sewer Division _____