

City of Prince George
HISTORY SHEET

SHEET NUMBER

Roll Number 0185/2119

Legal: LOT'S 39

BLOCK REM OF S.W. 1/4 D.L. 1599

PLAN 37628

Address: 5570 HEYER ROAD

Sanitary Connection: # SIZE 100 MATERIAL PVC INV. 729.280 CONNECTED

Water Connection # SIZE 20 MATERIAL Cu METER 1.25 @ 2.00 CONNECTED

Storm Connection: # SIZE 100 MATERIAL PVC INV. 729.300 CONNECTED

Cash Receipt No's: WATER SANITARY STORM

CURB FROM PROPERTY LINE 5.0m PAVEMENT WIDTH 10.0m

B.C. HYDRO U.G. UNDERGROUND CONNECTION

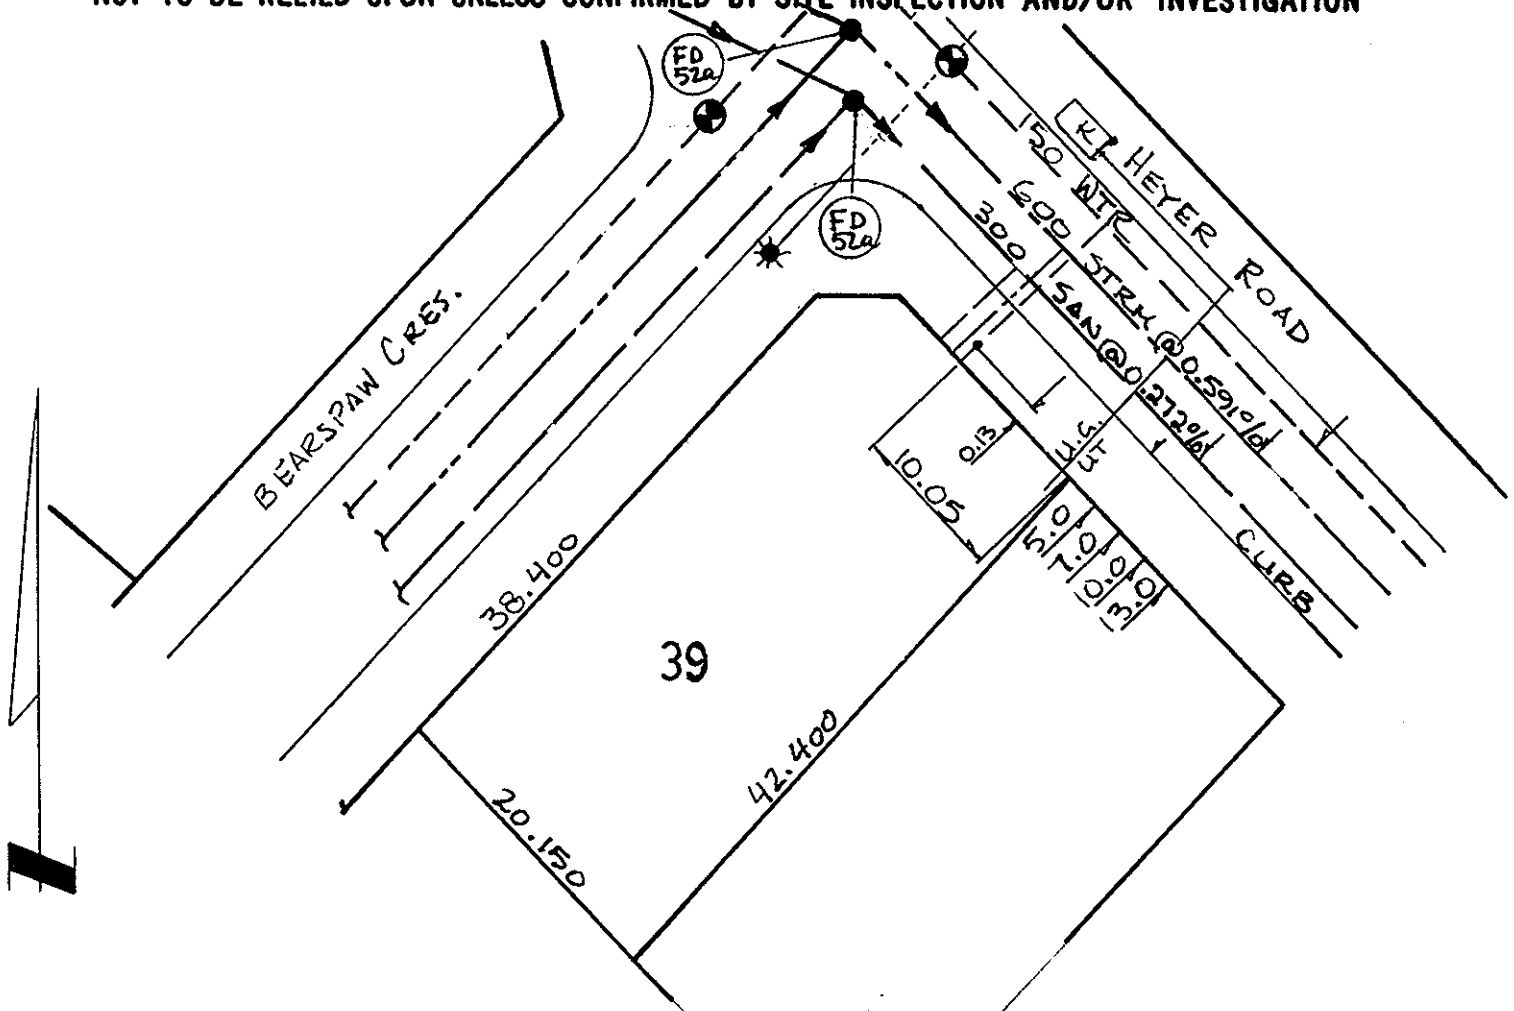
B.C. TELEPHONE U.G. UNDERGROUND CONNECTION

INLAND GAS 42mm ON HEYER RD, 1.5m FROM P.L.

Information Sheets:

Comments:

THE INFORMATION CONTAINED HEREIN IS FOR INTERNAL USE ONLY.
NOT TO BE RELIED UPON UNLESS CONFIRMED BY SITE INSPECTION AND/OR INVESTIGATION



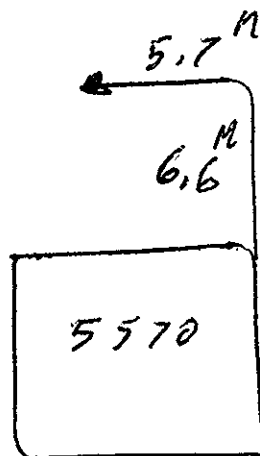
REPORT TO RECORDS

WATER SERVICE INFORMATION

Lot No. _____ Block _____ D.L. _____

Address 5570 HYERSize of Connection ☐ 1/2" ☒ 3/4" ☐ Other _____Type of Connection ☐ Copper ☐ IronThaw Wire ☐ Yes ☐ No

LOCATION SKETCH

HYER RD.Field Location By Alvin St. Croix Date MARCH 26/96

Checked by: _____

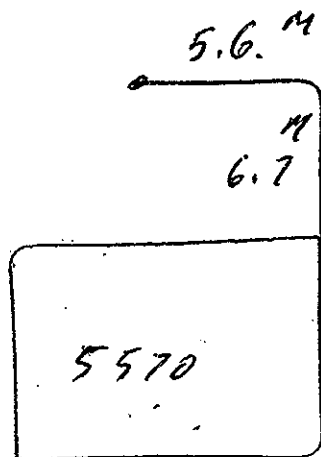
REPORT TO RECORDS

SEWER SERVICE INFORMATION

Lot No. _____ Block _____ D.L. _____

Address 5570 HYER RDSize of Connection ☒ 100mm ☐ 150mm ☐ 200mm ☐ Other _____Type of Connection ☐ Transite ☒ PVC ☐ Other _____Type of Cap ☐ Transite ☒ Cast Iron

LOCATION SKETCH

HYER RDField Location By ALAN J. COY Date MARCH 20/96

Checked by Foreman - Sewer Division _____