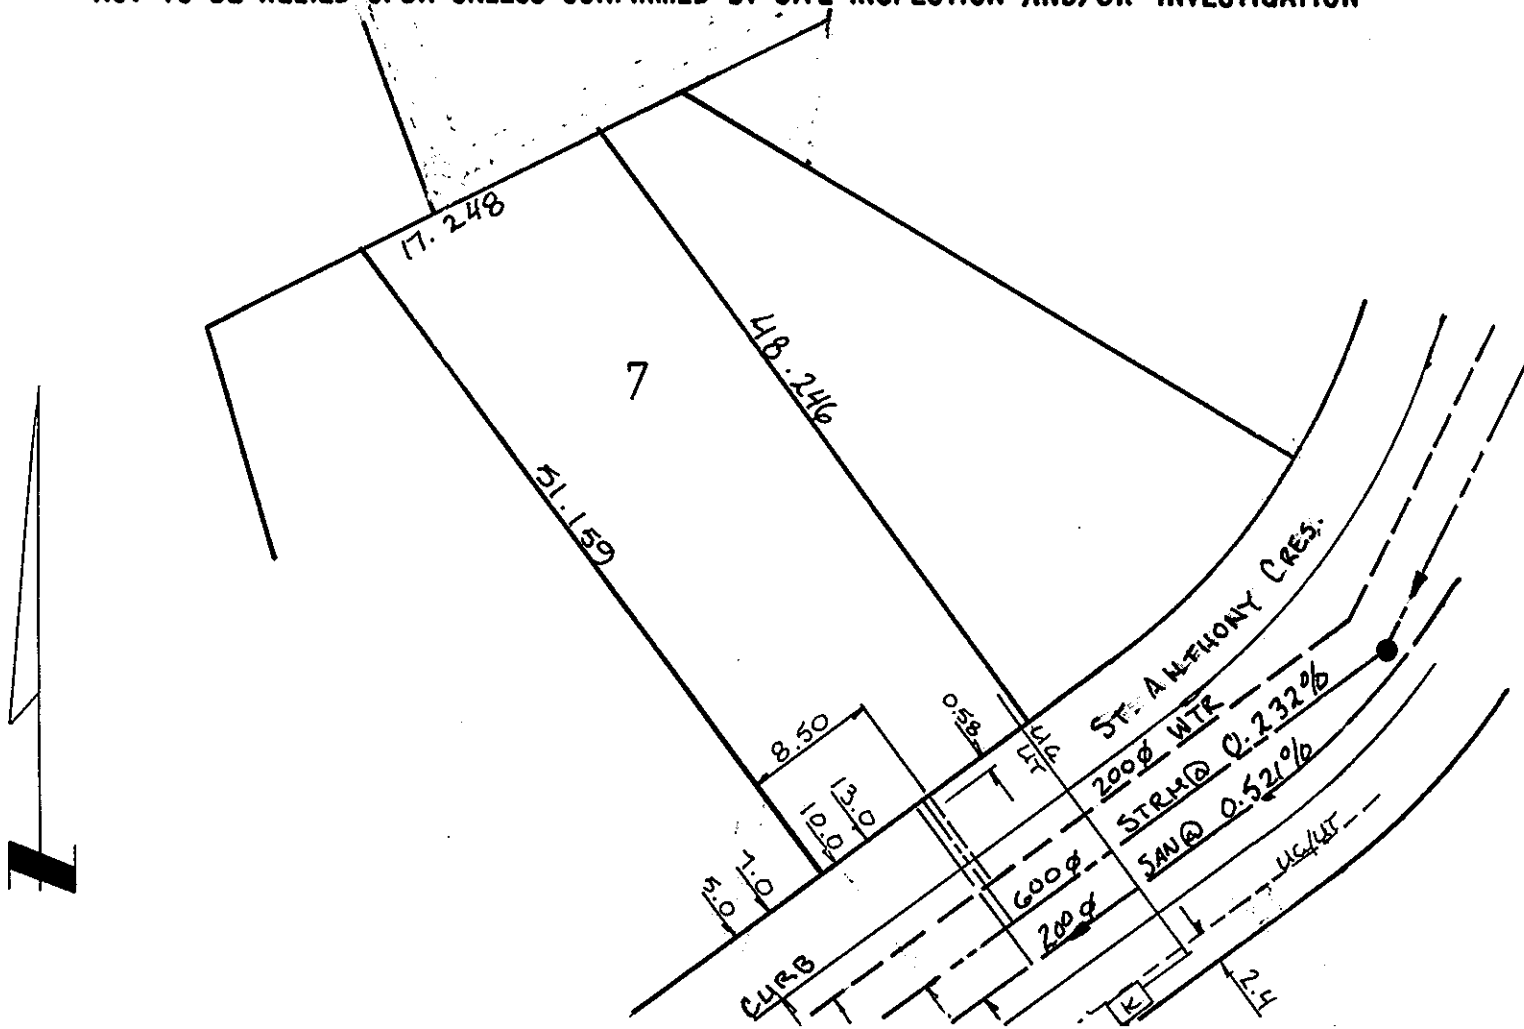


City of Prince George HISTORY SHEET

SHEET NUMBER		Roll Number 018529771	
Legal:	LOT'S 7	BLOCK	D.L. 2003 PLAN 37670
Address: 6989 St ANTHONY CRES.			
Sanitary Connection: #	SIZE 100	MATERIAL PVC	INV. 655.104 CONNECTED
Water Connection #	SIZE 20	MATERIAL CU	METER CONNECTED
Storm Connection: #	SIZE 100	MATERIAL PVC	INV. 654.984 CONNECTED
Cash Receipt No's:	WATER	SANITARY	STORM
CURB FROM PROPERTY LINE	Roll CURB 5.0m		PAVEMENT WIDTH 10.0m
B.C. HYDRO	U.C. 1.5m from P.L.		UNDERGROUND CONNECTION
B.C. TELEPHONE	U.C. 1.5m from P.L.		UNDERGROUND CONNECTION
INLAND GAS			
Information Sheets:			
Comments:			

THE INFORMATION CONTAINED HEREIN IS FOR INTERNAL USE ONLY.
NOT TO BE RELIED UPON UNLESS CONFIRMED BY SITE INSPECTION AND/OR INVESTIGATION

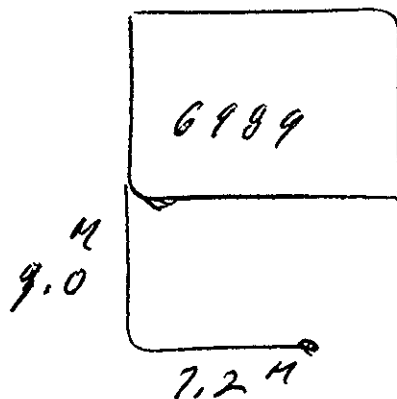


REPORT TO RECORDS

WATER SERVICE INFORMATION

Lot No. 7 Block 2003 D.L. _____Address 6989 ST. ANTHONYSize of Connection ☐ 1/2" ☒ 3/4" ☐ Other _____Type of Connection ☐ Copper ☐ IronThaw Wire ☐ Yes ☐ No

LOCATION SKETCH

ST. ANTHONYField Location By Alvin De Croy Date MARCH 1996

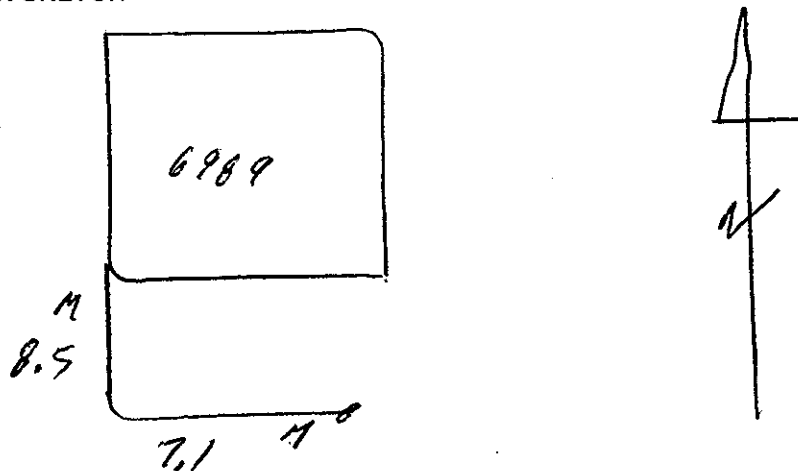
Checked by: _____

REPORT TO RECORDS

SEWER SERVICE INFORMATION

Lot No. 7 Block 2003 D.L. _____Address 6989 ST. ANTHONYSize of Connection ☒ 100mm ☐ 150mm ☐ 200mm ☐ Other _____Type of Connection ☐ Transite ☒ PVC ☐ Other _____Type of Cap ☐ Transite ☒ Cast Iron

LOCATION SKETCH

ST. ANTHONYField Location By Alan M. Croft Date MARCH 29/96

Checked by Foreman - Sewer Division _____