



City of Prince George History Sheet

PID:	018588697
SD/MU:	
WO:	

Civic Address: 3041 Bernard Rd

Legal Description: Lot: 1 District Lot: 754 Plan: PGP37743


Service Type	Diameter (mm)	Material	Invert Elev at main (m)	Depth of Cut at property line (m)	Invert Elev at service end (m)	Distance into property (m)	Installation Date
Sanitary	100mm	PVC	-	1.24	656.97	-	October 1993
Water	20mm	Copper	-	-	-	-	October 1993
Storm	100mm	PVC	-	1.16	657.06	-	October 1993

Service Connection Location				Sanitary (m)	Storm (m)
Distance from downstream San MH	4247	towards upstream San MH	4249	30.90	
Distance from downstream Stm MH	473	towards upstream Stm MH	483		16.90

Power	Size	Communications	Size	Cable	Size	Gas	Size
BC Hydro	-	Telus	-	Shaw	-	FortisBC	-
Overhead Service		Overhead Service		Overhead Service			

Installed by:	City of Prince George forces	Survey Date:	-
Comments:			

NOT TO SCALE The information contained herein is for internal use only.
Not to be relied on unless confirmed by site inspection and/or investigation.

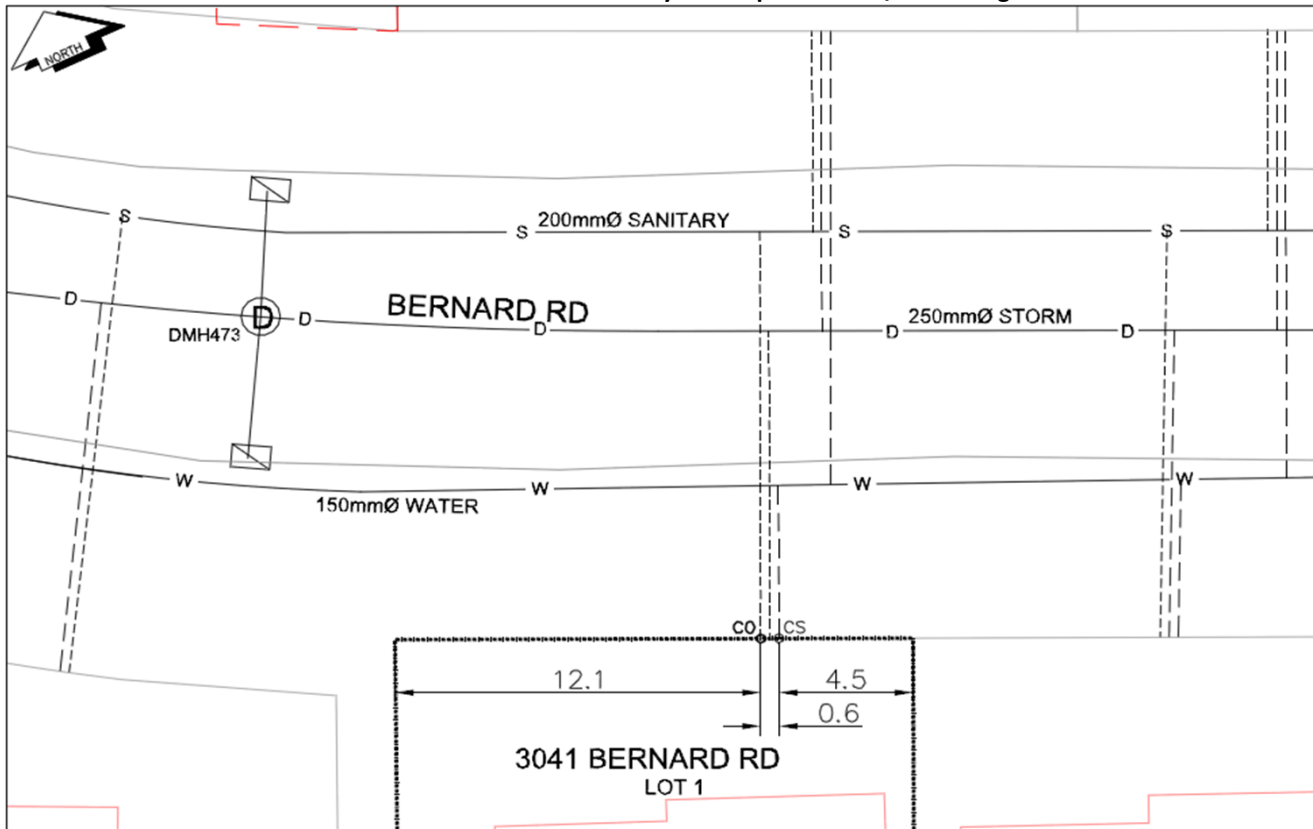

CS	CURB STOP	---	WATER SERVICE	---	STORM SERVICE
CO	CLEAN OUT	---	SANITARY SERVICE	---	WATER VALVE

NOT TO SCALE