



# City of Prince George History Sheet

PID:	018698735
SD/MU:	
WO:	5002012

Civic Address: 1401, 1427 Queensway

Legal Description: Lot: PCL 1 District Lot: 343 Plan: PGP37911


Service Type	Diameter (mm)	Material	Invert Elev at main (m)	Invert Elev at property line (m)	Invert Elev at service end (m)	Distance into property (m)	Installation Date
Sanitary (S1)	Unknown	Unknown	-	-	-	-	January 1956
Sanitary (S2)	Unknown	Unknown	-	-	-	-	January 1956
Water (W1)	20mm	Copper	-	-	-	-	January 1956
Water (W2)	20mm	Copper	-	-	-	-	June 2016
Water (W3)	20mm	Copper	-	-	-	-	January 1956
Storm	200mm	AC	-	-	-	-	January 1967

Service Connection Location			Sanitary (m)	Storm (m)
Distance from downstream San MH	-	towards upstream San MH	-	
Distance from downstream Stm MH	-	towards upstream Stm MH	-	

Power	Size	Communications	Size	Cable	Size	Gas	Size
BC Hydro	-	Telus	-	Shaw	-	FortisBC	-
Overhead Service		Overhead Service		Overhead Service			

Installed by:	Service W2 installed by City of Prince George forces	Survey Date:	-
Comments:			

**NOT TO SCALE** The information contained herein is for internal use only.  
Not to be relied on unless confirmed by site inspection and/or investigation.

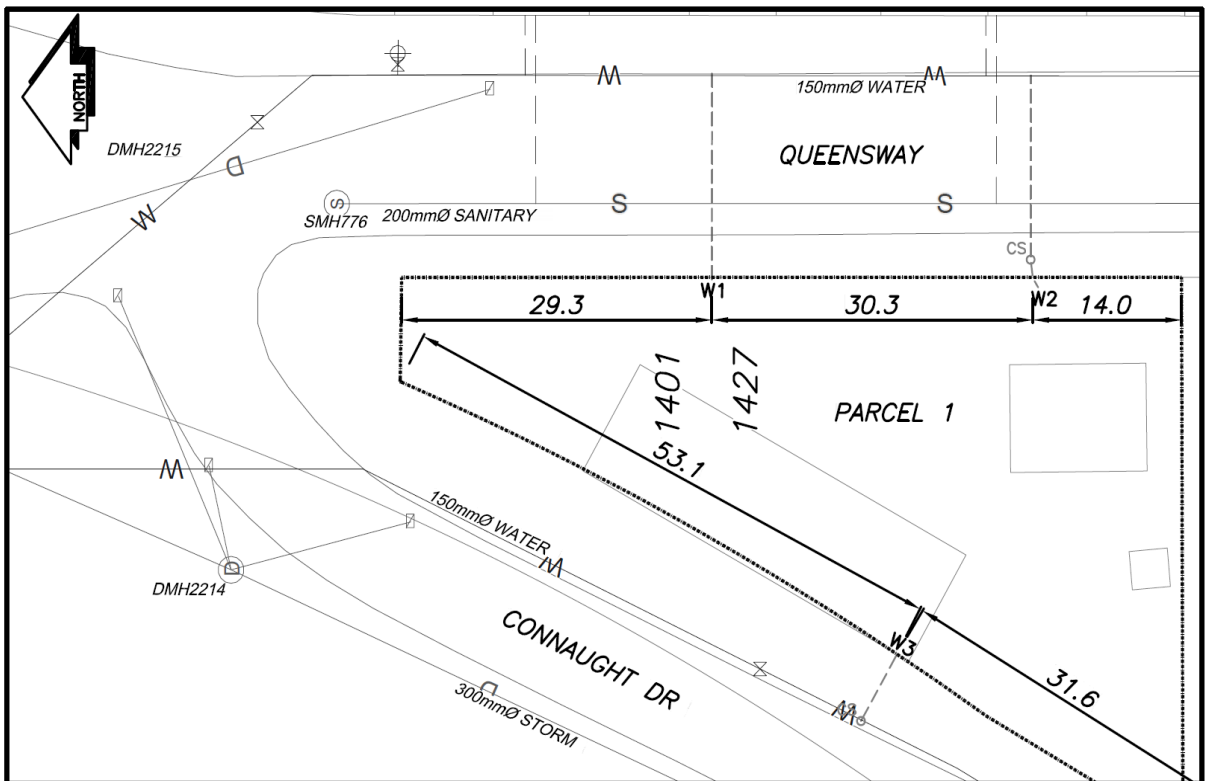

CS <sup>o</sup> CURB STOP	—M— WATER SERVICE	—M— STORM SERVICE
CO <sup>o</sup> CLEAN OUT	- - - - - SANITARY SERVICE	—G— GAS
⊗ WATER VALVE	⊗ FIRE HYDRANT	- - - - - ENCUMBRANCE

**NOT TO SCALE**