
City of Prince George HISTORY SHEET

	<u> </u>	IISTORY SHEET	W61 062 1
SHEET NUMBER			Roll Number
Legal: LOT'S A	BLOCK	D.L. 40	46 PLAN 37964
Address: 54	1/8 COON CR	VES.	
Sanitary Connection: #	SIZE 100	DMH MATERIAL PUR	INV. CONNECTED
Water Connection #	size 20	MATERIAL COPPER	METER CONNECTED
Storm Connection: #	SIZE	MATERIAL //	INV. CONNECTED
Cash Receipt No's:	water 13067	SANITARY /3067	STORM -
CURB FROM PROPERTY LINE			PAVEMENT WIDTH
B.C. HYDRO O. H.		UNDERGROUND CONNECT	ION
B.C. TELEPHONE O. H.		UNDERGROUND CONNECT	ION
INLAND GAS AS S	HOX		
Information Sheets:			

THE INFORMATION CONTAINED HEREIN IS FOR INTERNAL USE ONLY.
NOT TO BE RELIED UPON UNLESS CONFIRMED BY SITE INSPECTION AND/OR INVESTIGATION

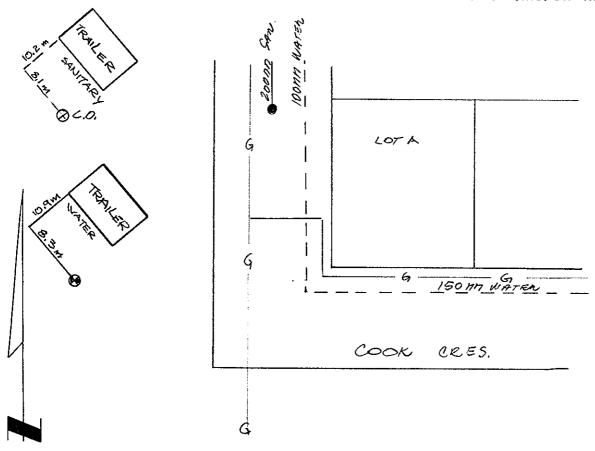

Comments: