



City of Prince George History Sheet

PID:	018856144
SD/MU:	
WO:	

Civic Address: 8206 St Patrick Ave

Legal Description: Lot: 2 District Lot: 1605 Plan: PGP38161


Service Type	Diameter (mm)	Material	Invert Elev at main (m)	Invert Elev at property line (m)	Invert Depth at service end (m)	Distance into property (m)	Installation Date
Sanitary	100mm	AC	-	652.99	4.57	-	January 1979
Water	20mm	Copper	-	-	-	-	January 1978
Storm	100mm	AC	-	652.98	4.57	-	January 1978

Service Connection Location				Sanitary (m)	Storm (m)
Distance from downstream San MH	4616	towards upstream San MH	4617	27.22	
Distance from downstream Stm MH	2346	towards upstream Stm MH	2360		59.61

Power	Size	Communications	Size	Cable	Size	Gas	Size
BC Hydro	-	Telus	-	Shaw	-	FortisBC	-
Underground Service		Underground Service		Underground Service			

Installed by:	Survey Date:	-
Comments:	Water service location confirmed October 2016.	

NOT TO SCALE The information contained herein is for internal use only.
Not to be relied on unless confirmed by site inspection and/or investigation.

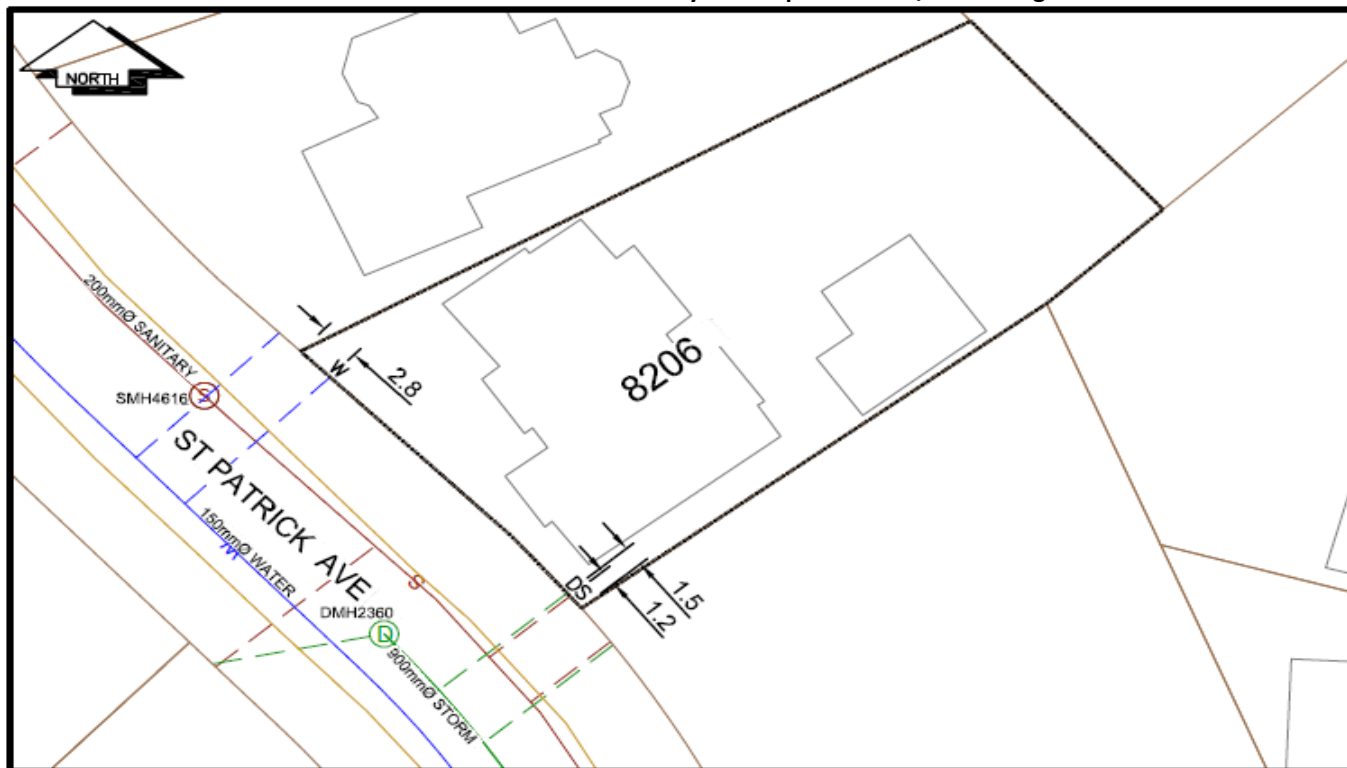

LEGEND:	CS CURB STOP	--- WATER SERVICE	--- STORM SERVICE
	CO CLEAN OUT	-S- SANITARY SERVICE	-G- GAS

NOT TO SCALE