

## City of Prince George **History Sheet**

018887813	PID:
	SD/MU:
	WO:

Survey Date:

- - ENCUMBERANCE

-

## **Civic Address:** 826 Victoria St

1635 8th Ave

Legal Description: Lot: PCL A District Lot: 343 Plan: PGP38215

Service Type	Diameter (mm)	Material	Invert Elev at main (m)	Invert Elev at property line (m)	Invert Depth at service end (m)	Distance into property (m)	Installation Date
Sanitary	100mm	AC	-	574.63	1.28	-	January 1957
Water	25mm	Copper	-	-	-	-	January 1957
Storm	200mm	PVC	-	-	-	-	January 1965
Service Connection Distance from dov	wnstream San MH	3101	towards up	ostream San MH	3099	Sanitary (m) 23.17	Storm (m)
Distance from dov	wnstream San MH	3101	towards up	ostream San MH	3099	23.17	
200mm Storm service connected to Stm MH1310							
Power	Size	Communications	Size	Cable	Size	Gas	Size
BC Hydro	-	Telus	-	Shaw	-	FortisBC	-
Overhead	d Service	Overhead	Sorvico	Overhead	Sonvico		


## Installed by:

LEGEND:

Water and Sanitary srvices location confirmed July 01, 2017 Comments:

WATER VALVE

NOT TO SCALE The information contained herein is for internal use only. Not to be relied on unless confirmed by site inspection and/or investigation.

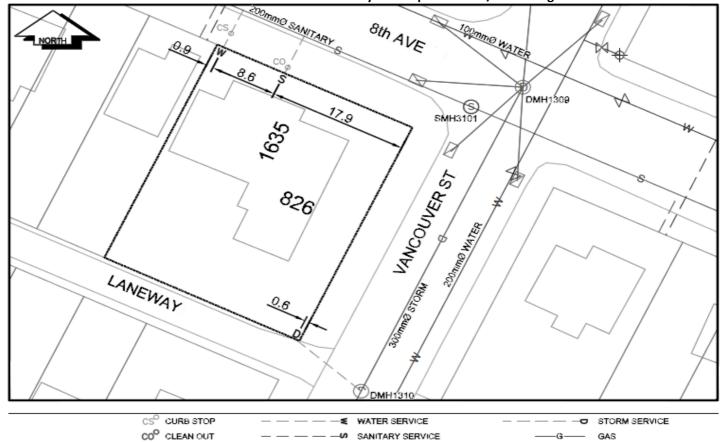

FIRE HYDRANT

## NOT TO SCALE