

City of Prince George
HISTORY SHEET

SHEET NUMBER

Roll Number 019114460

Legal: LOT'S B BLOCK 1605 PLAN 38563

Address: 7025 O'GRADY RD.

Sanitary Connection: # SIZE 100 ϕ (2) MATERIAL PVC INV. CONNECTED

Water Connection # SIZE 19 ϕ (2) MATERIAL Copper METER No CONNECTED

Storm Connection: # SIZE 100 ϕ (2) MATERIAL PVC INV. CONNECTED

Cash Receipt No's: WATER SANITARY STORM

CURB FROM PROPERTY LINE 5.69 m (ROLL CURB) PAVEMENT WIDTH 13.0


B.C. HYDRO $\frac{1}{8}$ 1.5 From R UNDERGROUND CONNECTION (2)

B.C. TELEPHONE $\frac{1}{8}$ 1.8 From R UNDERGROUND CONNECTION (2)

INLAND GAS $\frac{1}{8}$ 0.2 From R (Design) Easement around Hydro Kiosk

Information Sheets:

Comments: Duplex Lot - 2 sets of connections provided

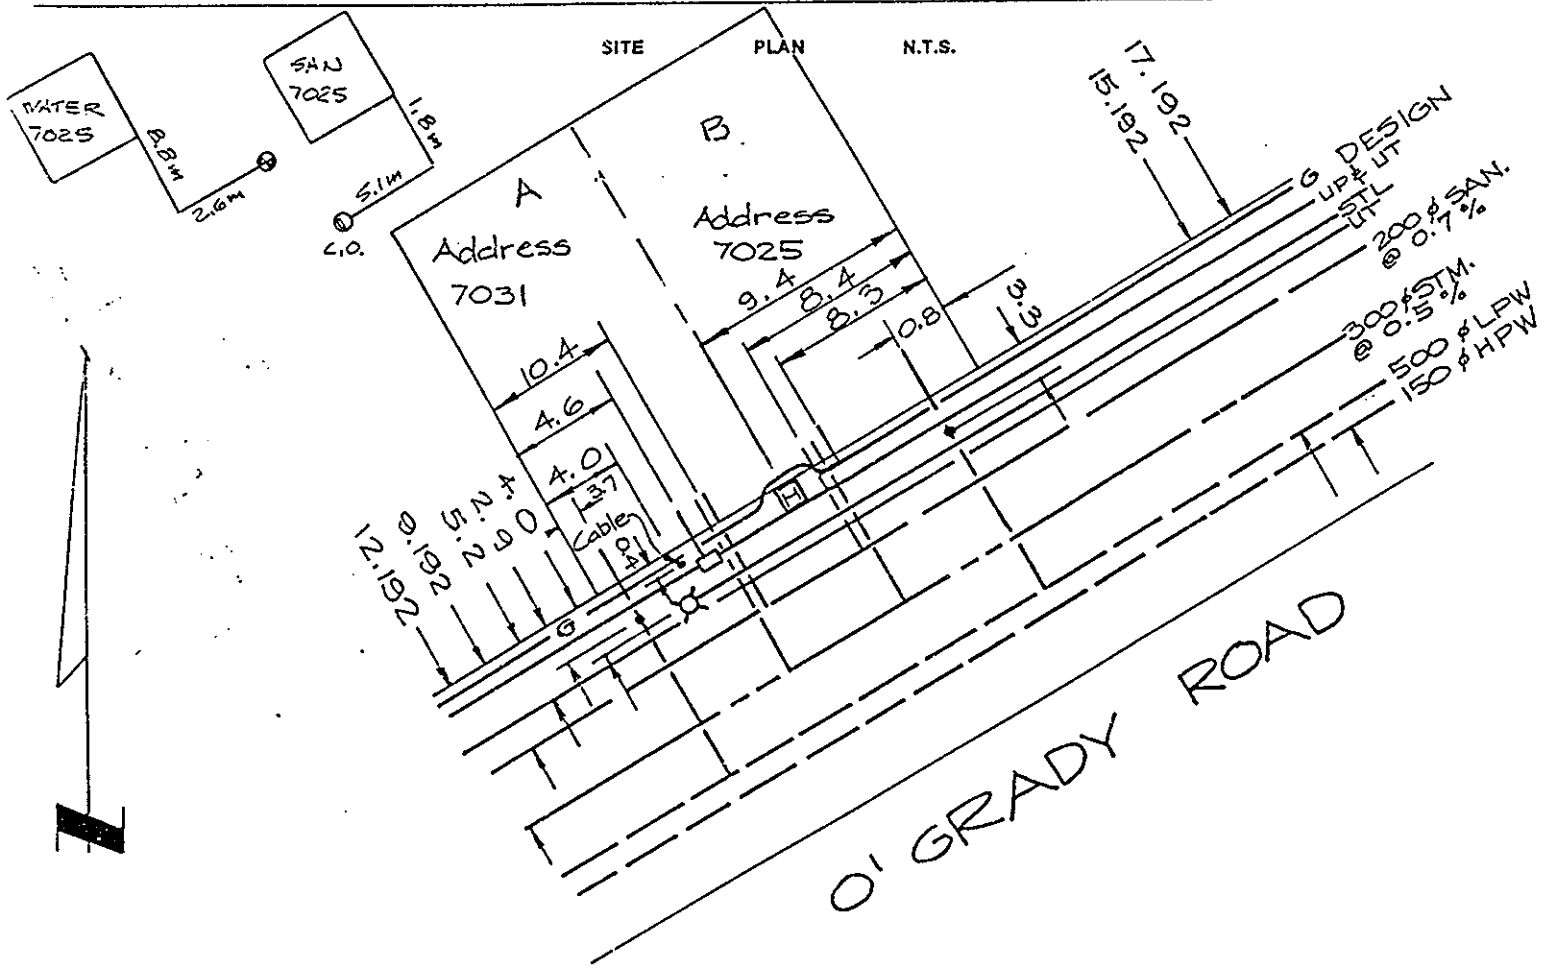


REPORT TO RECORDS

SEWER SERVICE INFORMATION

Lot No. 2 Block 2003 1605 D.L. 38550Address 7025 O'GRADY RD.Size of Connection ☒ 100mm ☐ 150mm ☐ 200mm ☐ Other _____Type of Connection ☐ Transite ☒ PVC ☐ Other _____Type of Cap ☐ Transite ☒ Cast Iron

LOCATION SKETCH

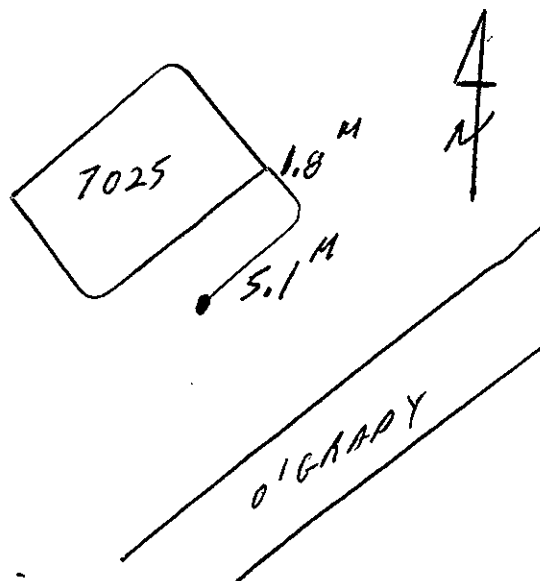Field Location By Alain J. Croix Date AUG. 25-95

Checked by Foreman - Sewer Division _____