

City of Prince George
HISTORY SHEET

SHEET NUMBER

Roll Number 019125950

Legal: LOT'S 38 BLOCK D.L. 1605 PLAN 38585

Address: 3248 VISTA RIDGE PLACE

Sanitary Connection: # SIZE 100 Ø MATERIAL P.V.C. INV. CONNECTED

Water Connection # SIZE 19 Ø MATERIAL COPPER METER CONNECTED

Storm Connection: # SIZE 100 Ø MATERIAL P.V.C. INV. CONNECTED

Cash Receipt No's: WATER SANITARY STORM

CURB FROM PROPERTY LINE 5.0 (DESIGN) PAVEMENT WIDTH N/A

B.C. HYDRO 0/S 265 FROM R UNDERGROUND CONNECTION EDGE LOT

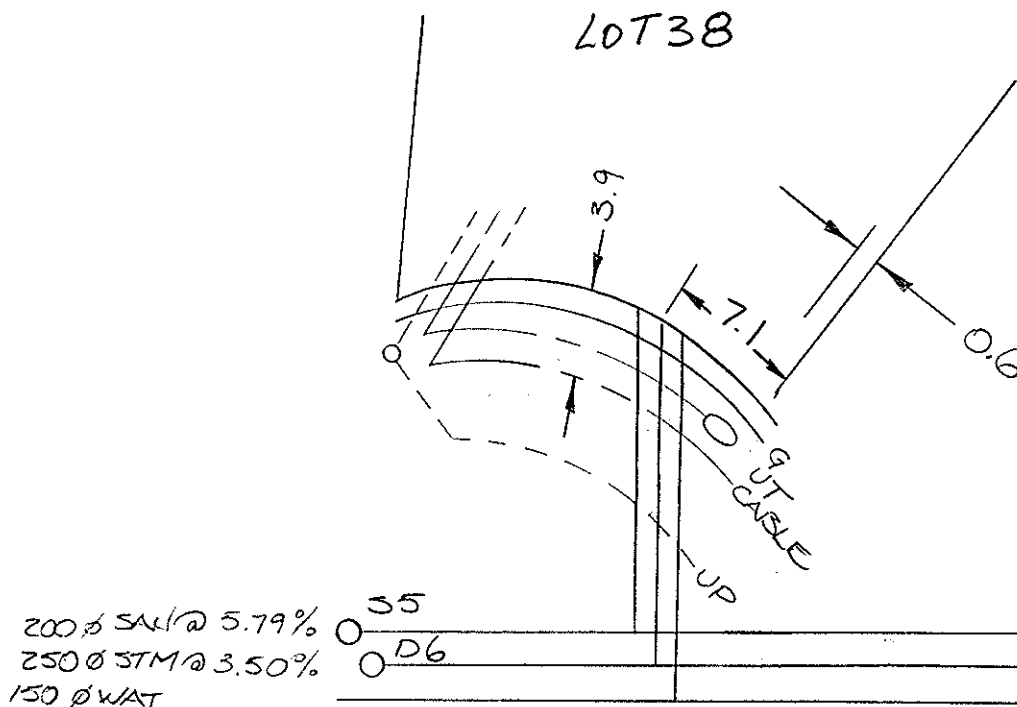
B.C. TELEPHONE 0/S 3.5 FROM R UNDERGROUND CONNECTION EDGE LOT

INLAND GAS 0/S 1.5 FROM R

Information Sheets:

Comments:

THE INFORMATION CONTAINED HEREIN IS FOR INTERNAL USE ONLY.
NOT TO BE RELIED UPON UNLESS CONFIRMED BY SITE INSPECTION AND/OR INVESTIGATION



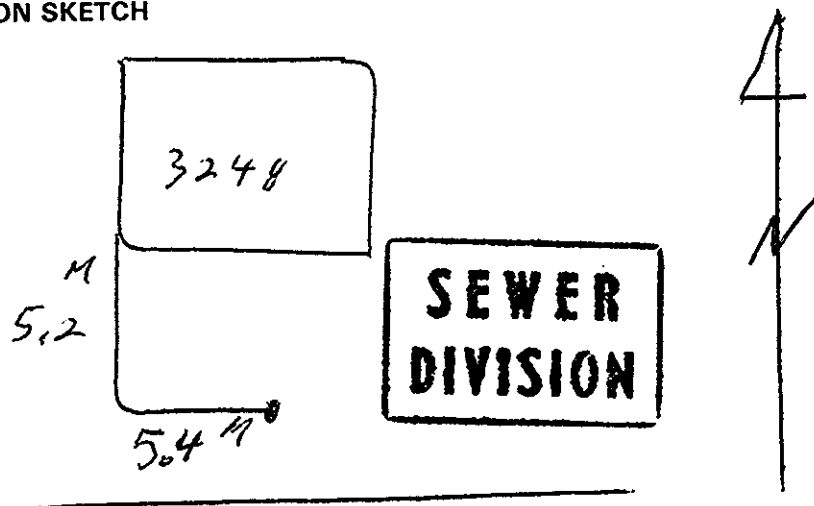
019125450

REPORT TO RECORDS

WATER SERVICE INFORMATION

Lot No. 38 Block 1605 D.L. 38585Address 3248 VISTA RIDGE.Size of Connection ☐ 1/2" ☒ 3/4" ☐ Other _____Type of Connection ☐ Copper ☐ IronThaw Wire ☐ Yes ☐ No

LOCATION SKETCH

VISTA RIDGE.Field Location By A. Louis St. Croix Date MARCH 26/96

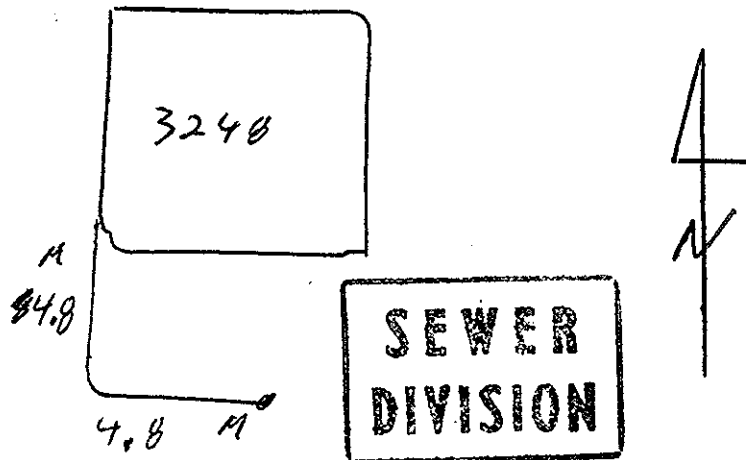
Checked by: _____

REPORT TO RECORDS

SEWER SERVICE INFORMATION

Lot No. 38 Block 1605 D.L. 38585Address 3248 VISTA AZDUESize of Connection ☒ 100mm ☐ 150mm ☐ 200mm ☐ OtherType of Connection ☐ Transite ☒ PVC ☐ OtherType of Cap ☐ Transite ☒ Cast Iron

LOCATION SKETCH

Field Location By A. Davis St Croix Date MARCH 26/96

Checked by Foreman - Sewer Division _____