



Legal Description: Lot: PCL 'B' Block: 128 District Lot: 343 Plan: 1268 (PJ5483)

PID:	019150679
------	-----------

Service Type	Diameter (mm)	Material	Invert Elev @ Main (m)	Invert Elev @ Property Line (m)	Invert Elev @ Service End (m)	Distance into Property (m)	Installation Date
Sanitary	150	AC	2.4	-	-	-	-
Water	100	PVC	578.83	-	-	10	2022
Storm	150	AC	1.9	-	-	-	-

Sanitary Service Connection Location Notes	Storm Service Connection Location Notes
Distance from downstream SAN MH #2700: 18.40M	Distance from downstream STM MH #: N/A
Distance to upstream SAN MH 2698: 31.66M	Distance to upstream STM MH #: N/A

Power	Communications	Cable	Gas
BC Hydro	TELUS	Shaw Cable	FortisBC
Overhead Service	Overhead Service	Overhead Service	Underground Service


Installation By:	WATER INSTALLED BY COPG 2022	Draft Date:	-	Survey Date:	-
-------------------------	------------------------------	--------------------	---	---------------------	---









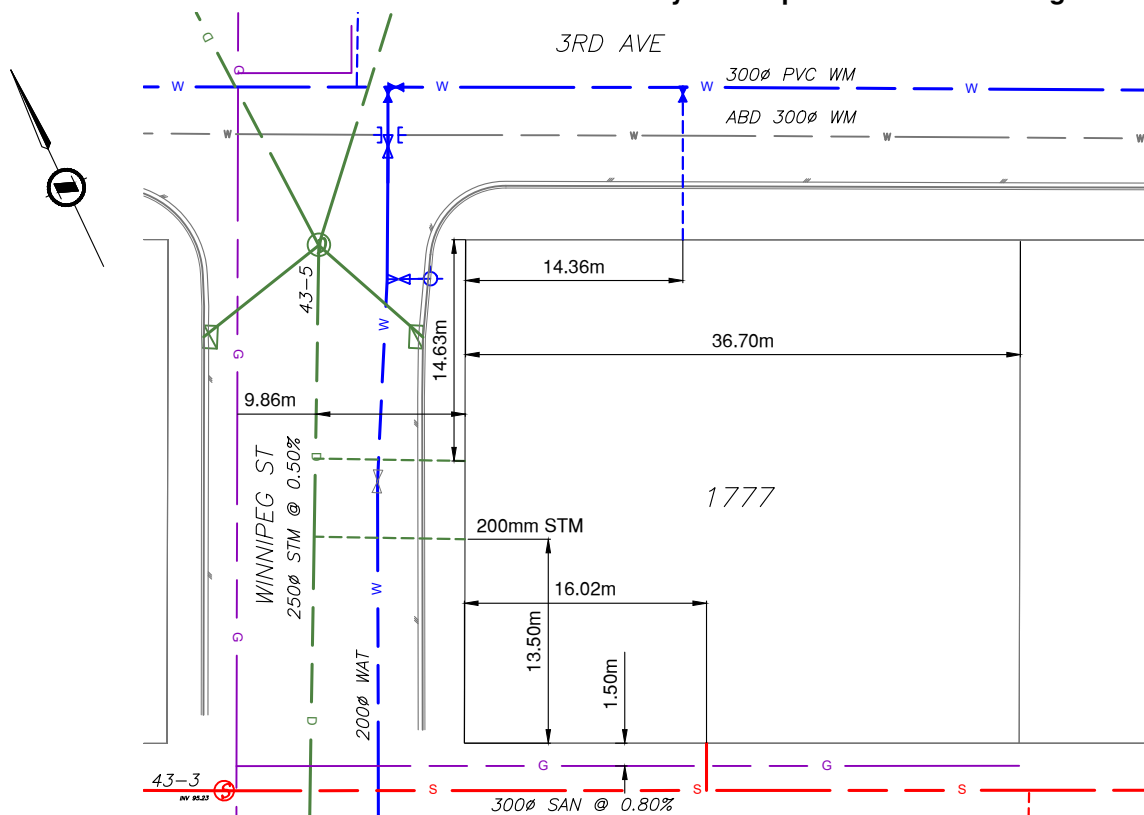

Comments: WATER SERVICE INSULATED WITH RIGID INSULATION

INLAND GAS: IN LANE 2"Ø MAIN

CURB FROM PL: 10'

NOT TO SCALE The information contained herein is for internal use only.
Not to be relied on unless confirmed by site inspection and/or investigation.



	WATER SERVICE AND CURB STOP (CS)		UNDERGROUND GAS LINE
	WATER HYDRANT LEAD, VALVE, HYDRANT		WATER MAIN
	SANITARY SERVICE AND CLEAN OUT (CO)		SANITARY MAIN
	STORM SERVICE		STORM MAIN
	ROAD EDGE		ENCUMBRANCE