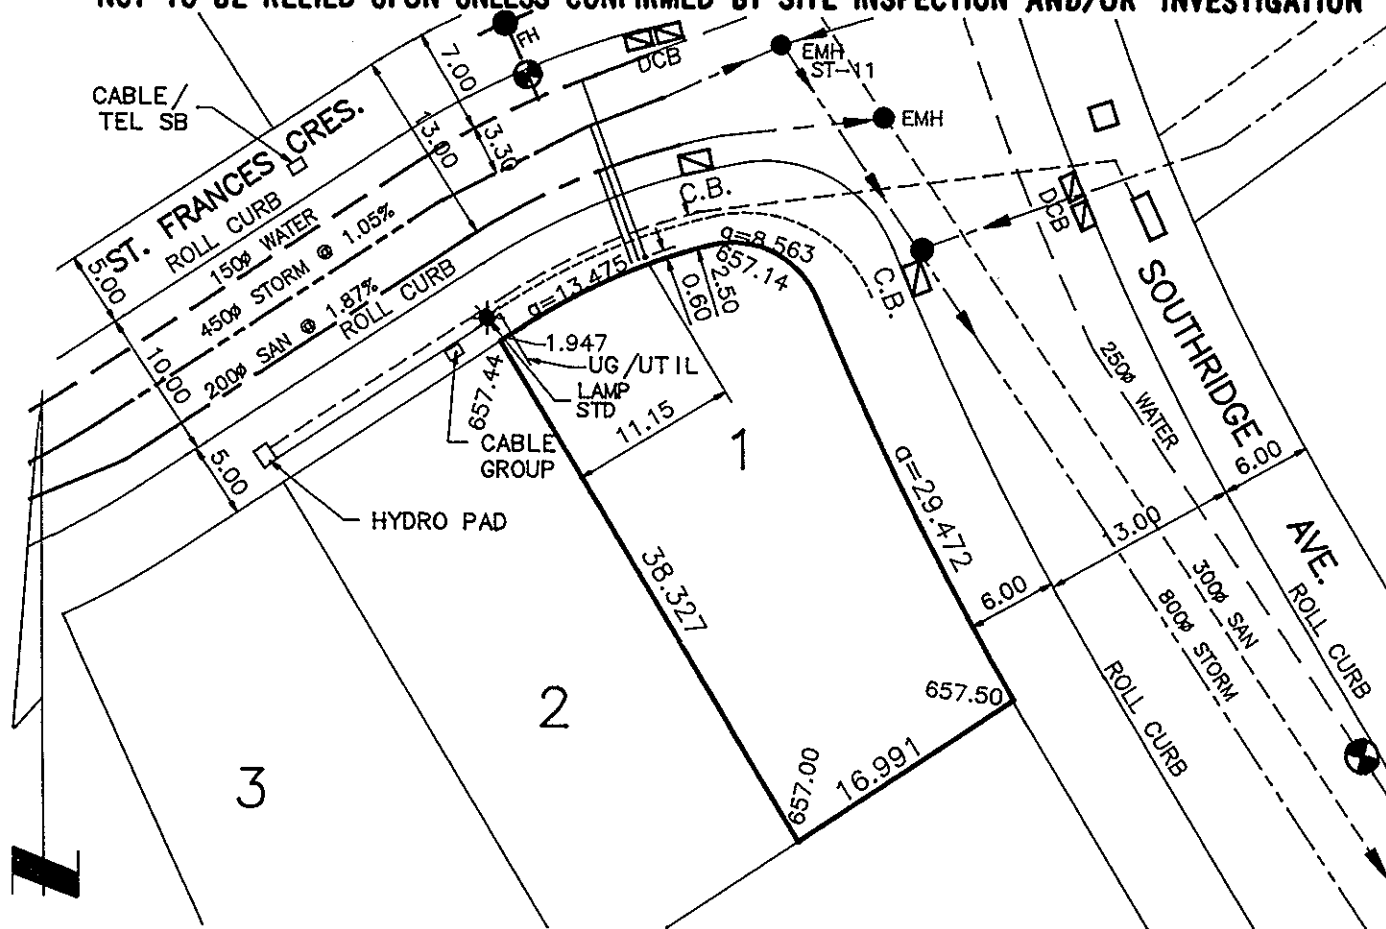


SHEET NUMBER		Roll Number 019154950	
Legal:	LOT'S 1	BLOCK	D.L. 2003 PLAN 38667
Address: 3201 ST FRANCES CRES.			
Sanitary Connection:	#	SIZE 100	MATERIAL PVC INV. 655.153 CONNECTED
Water Connection	#	SIZE 20	MATERIAL Cu METER CONNECTED
Storm Connection:	#	SIZE 100	MATERIAL PVC INV. 655.173 CONNECTED
Cash Receipt No's:	WATER	SANITARY	STORM
CURB FROM PROPERTY LINE 5.0m ST. FRANCES CR. 6.0m SOUTHRIDGE PAVEMENT WIDTH 10.0m ; 13.0m			
B.C. HYDRO	U/A 1.0m fr WEST P.L.	UNDERGROUND CONNECTION	
B.C. TELEPHONE	U/A 1.0m fr WEST P.L.	UNDERGROUND CONNECTION	
INLAND GAS			
Information Sheets:			
Comments:			

THE INFORMATION CONTAINED HEREIN IS FOR INTERNAL USE ONLY.  
NOT TO BE RELIED UPON UNLESS CONFIRMED BY SITE INSPECTION AND/OR INVESTIGATION



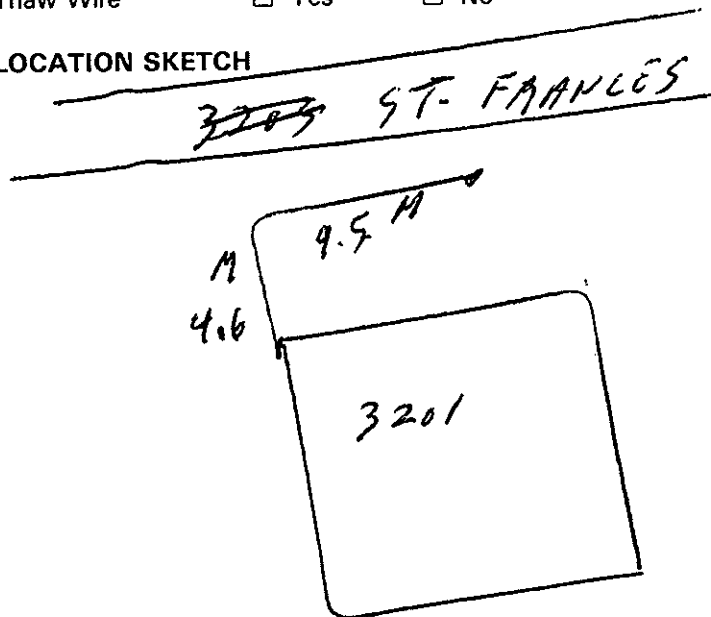
019154950

## REPORT TO RECORDS

## WATER SERVICE INFORMATION

Lot No. 1 Block 2003 D.L. \_\_\_\_\_Address 3201 ST. FRANCESSize of Connection ☐ 1/2" ☒ 3/4" ☐ Other \_\_\_\_\_Type of Connection ☐ Copper ☐ IronThaw Wire ☐ Yes ☐ No

## LOCATION SKETCH

Field Location By Alain Le Croy Date MARCH 29/96.

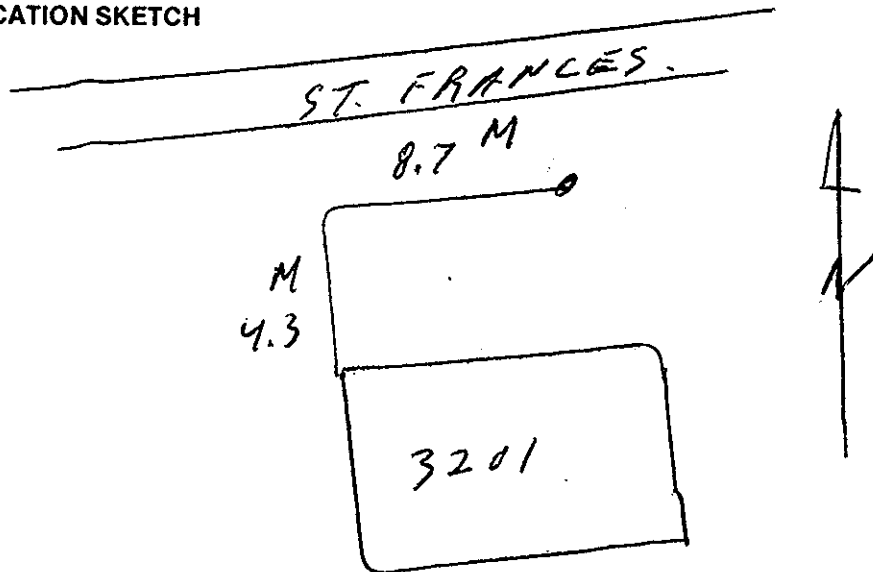
Checked by: \_\_\_\_\_

**REPORT TO RECORDS**

## SEWER SERVICE INFORMATION

Lot No. 1 Block 2003 D.L. \_\_\_\_\_Address 3201 ST. FRANCES.Size of Connection ☒ 100mm ☐ 150mm ☐ 200mm ☐ Other \_\_\_\_\_Type of Connection ☐ Transite ☒ PVC ☐ Other \_\_\_\_\_Type of Cap ☐ Transite ☒ Cast Iron

## LOCATION SKETCH

Field Location By ALAN R. COY Date MARCH 25/96.

Checked by Foreman - Sewer Division \_\_\_\_\_