



City of Prince George History Sheet

PID:	004397584
SD/MU:	
WO:	

Civic Address: 3219 St Frances Cres

Legal Description: Lot: 3 District Lot: 2003 Plan: PGP38667


Service Type	Diameter (mm)	Material	Invert Elev at main (m)	Invert Elev at property line (m)	Invert Depth at service end (m)	Distance into property (m)	Installation Date
Sanitary	100mm	PVC	654.62	655.61	2.50	-	January 1995
Water	20mm	Copper	-	-	-	-	January 1995
Storm	100mm	PVC	-	655.56	2.55	-	January 1995

Service Connection Location				Sanitary (m)	Storm (m)
Distance from downstream San MH	4239	towards upstream San MH	4242	53.12	
Distance from downstream Stm MH	-	towards upstream Stm MH	-		

Power	Size	Communications	Size	Cable	Size	Gas	Size
BC Hydro	-	Telus	-	Shaw	-	FortisBC	-
Underground Service		Underground Service		Underground Service			

Installed by:	Survey Date:	-
Comments:	Water service confirmed June 16, 2017	

NOT TO SCALE The information contained herein is for internal use only.
Not to be relied on unless confirmed by site inspection and/or investigation.

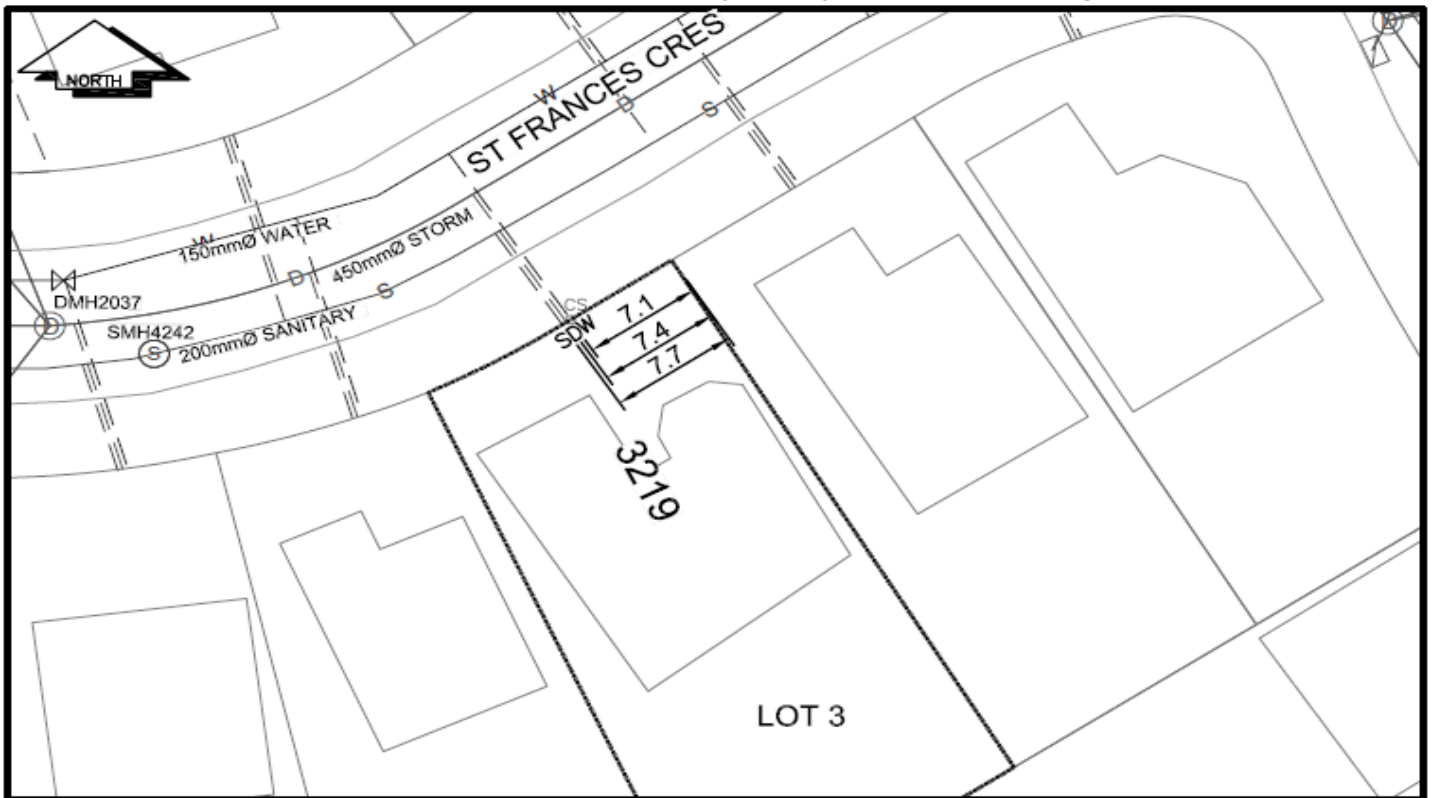

CS	CURB STOP	---	WATER SERVICE	---	STORM SERVICE
CO	CLEAN OUT	---	SANITARY SERVICE	---	GAS
WV	WATER VALVE	---	FIRE HYDRANT	---	ENCUMBRANCE

NOT TO SCALE