

City of Prince George  
HISTORY SHEET

SHEET NUMBER

Roll Number 023198796

Legal: LOT'S Lot B BLOCK D.L. 2003/754 PLAN 39295

Address: 3054 BERNARD ROAD

Sanitary Connection: # SIZE 100MM MATERIAL PVC INV. CONNECTED

Water Connection # SIZE 20MM MATERIAL Copper METER CONNECTED

Storm Connection: # SIZE 100mm MATERIAL INV. CONNECTED

Cash Receipt No's: WATER SANITARY STORM

CURB FROM PROPERTY LINE PAVEMENT WIDTH

B.C. HYDRO 0/H UNDERGROUND CONNECTION

B.C. TELEPHONE 0/H UNDERGROUND CONNECTION


INLAND GAS AS SHOWN

Information Sheets:

Comments:

THE INFORMATION CONTAINED HEREIN IS FOR INTERNAL USE ONLY.

NOT TO BE RELIED UPON UNLESS CONFIRMED BY SITE INSPECTION AND/OR INVESTIGATION

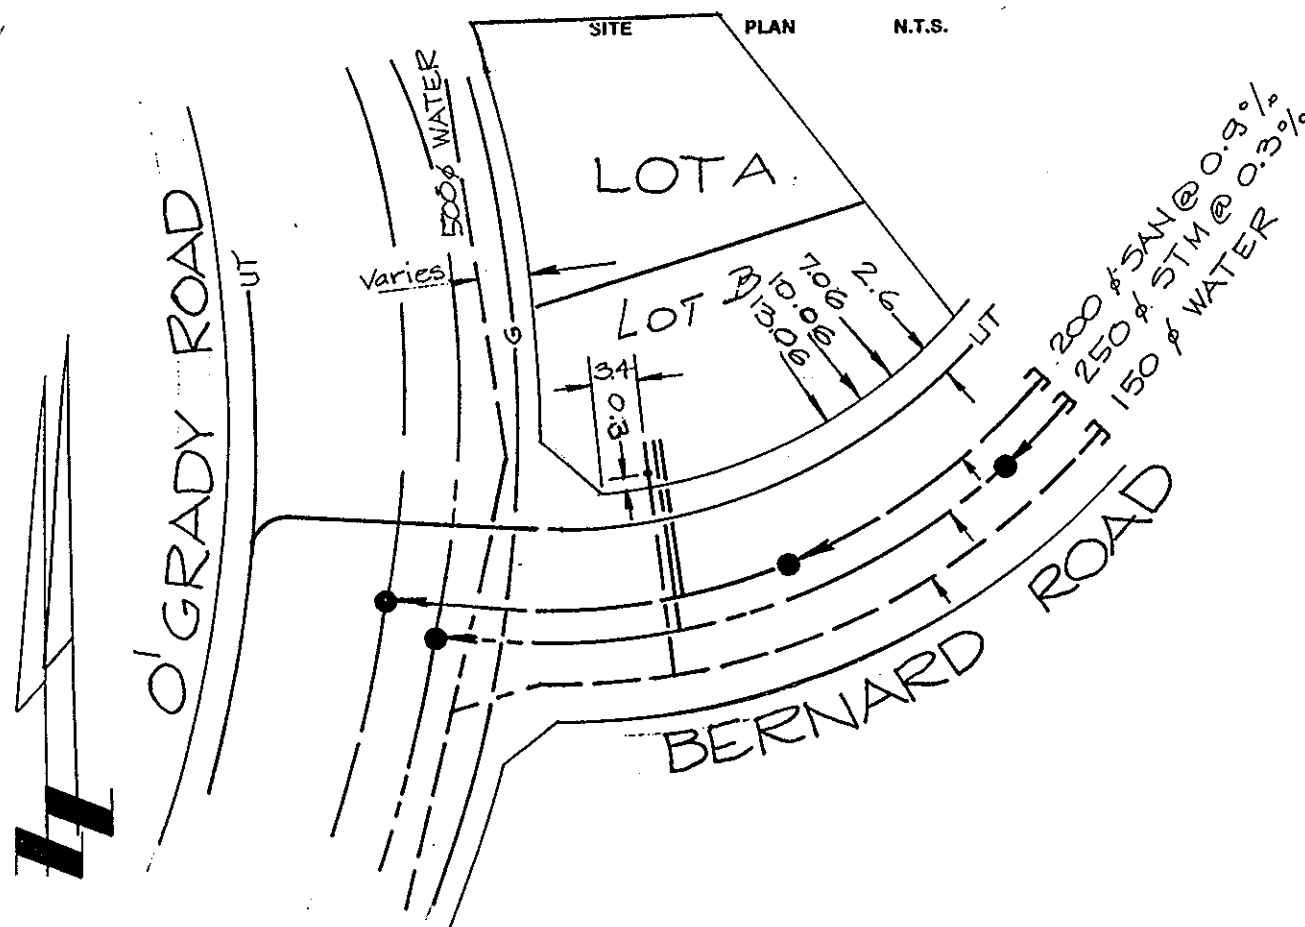

# REPORT TO RECORDS

## WATER SERVICE INFORMATION

Lot No. B Block 754 D.L. 39295

Address 3054 BERNARD RD.


Size of Connection ☐ 1/2" ☒ 3/4" ☐ Other \_\_\_\_\_

Type of Connection ☐ Copper ☐ Iron ☒ PLASTIC

Thaw Wire ☒ Yes ☐ No

## LOCATION SKETCH

4  
M

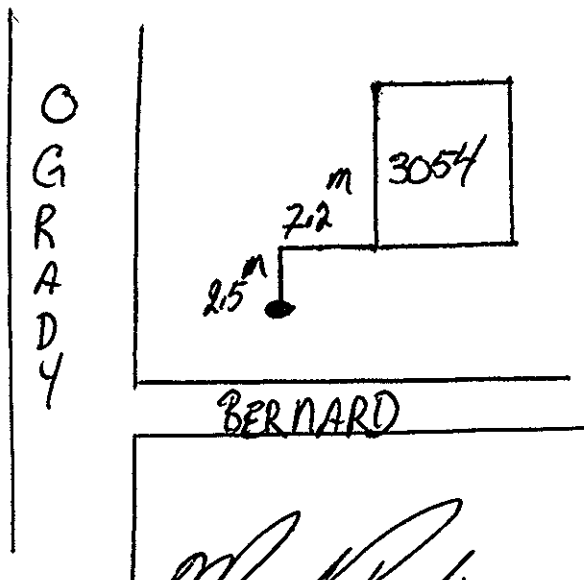

Field Location By Walter Pouch Date SEPT 18/95

Checked by: \_\_\_\_\_