



City of Prince George History Sheet

PID:	023207302
MU:	101849
WO:	92298/92297
	92299

Civic Address: 6797 Westgate Ave

Legal Description: Lot: 49 District Lot: 1600 Plan: PGP39361


Service Type	Diameter (mm)	Material	Invert Elev at main (m)	Invert Elev at property line (m)	Invert Elev at service end (m)	Distance into property (m)	Installation Date
Sanitary	150mm	PVC	732.10	-	-	-	June 2017
Water	200mm	PVC	-	-	731.51	-	June 2017
Storm	300mm	PVC	729.17	-	-	-	June 2017

Service Connection Location	Sanitary (m)	Storm (m)
150mm Sanitary service connected to San MH	-	
300mm Storm service connected to Stm MH		

Power	Size	Communications	Size	Cable	Size	Gas	Size
BC Hydro	-	Telus	-	Shaw	-	FortisBC	-
Underground Service		Underground Service		Underground Service			

Installed by:	City of Prince George forces	Survey Date:	-
Comments:			

NOT TO SCALE The information contained herein is for internal use only.
Not to be relied on unless confirmed by site inspection and/or investigation.

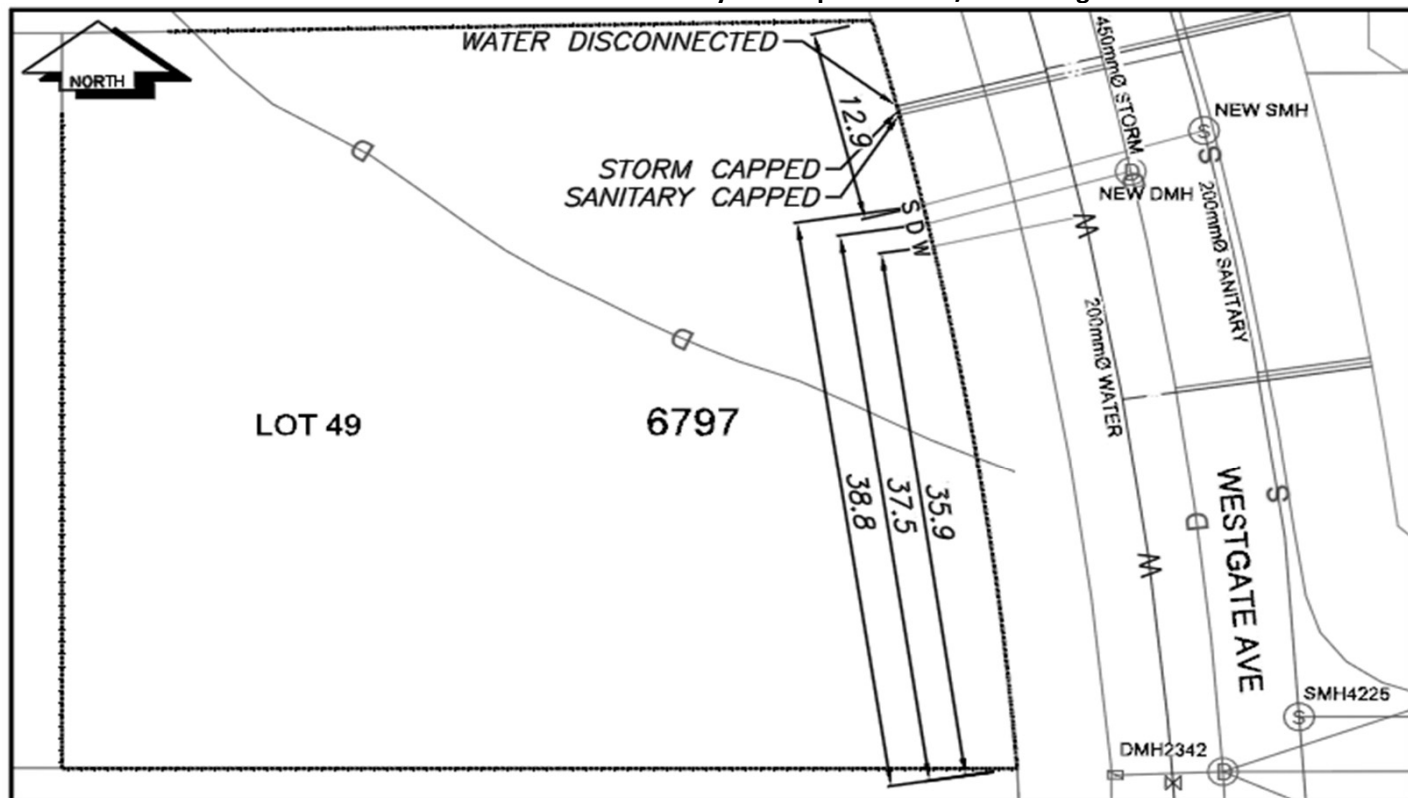

CS ^o CURB STOP	W WATER SERVICE	o STORM SERVICE
CO ^o CLEAN OUT	S SANITARY SERVICE	G GAS
⊗ WATER VALVE	⊗ FIRE HYDRANT	--- ENCUMBRANCE

NOT TO SCALE