


## Lot Servicing

6700 CHECKLEY RD

PID: 023316179

Lot: 1, Plan: PGP39683, DL: 754

SERVICE	SIZE	MATERIAL	INSTALLED DATE	LOCATION	DETAILS
WATER	20MM	CU		10.65M N OF SW COR PL	THAW WIRE Y
SANITARY	100MM	PVC		10.65M N OF SW COR PL	
STORM	100MM	PVC		10.65M N OF SW COR PL	

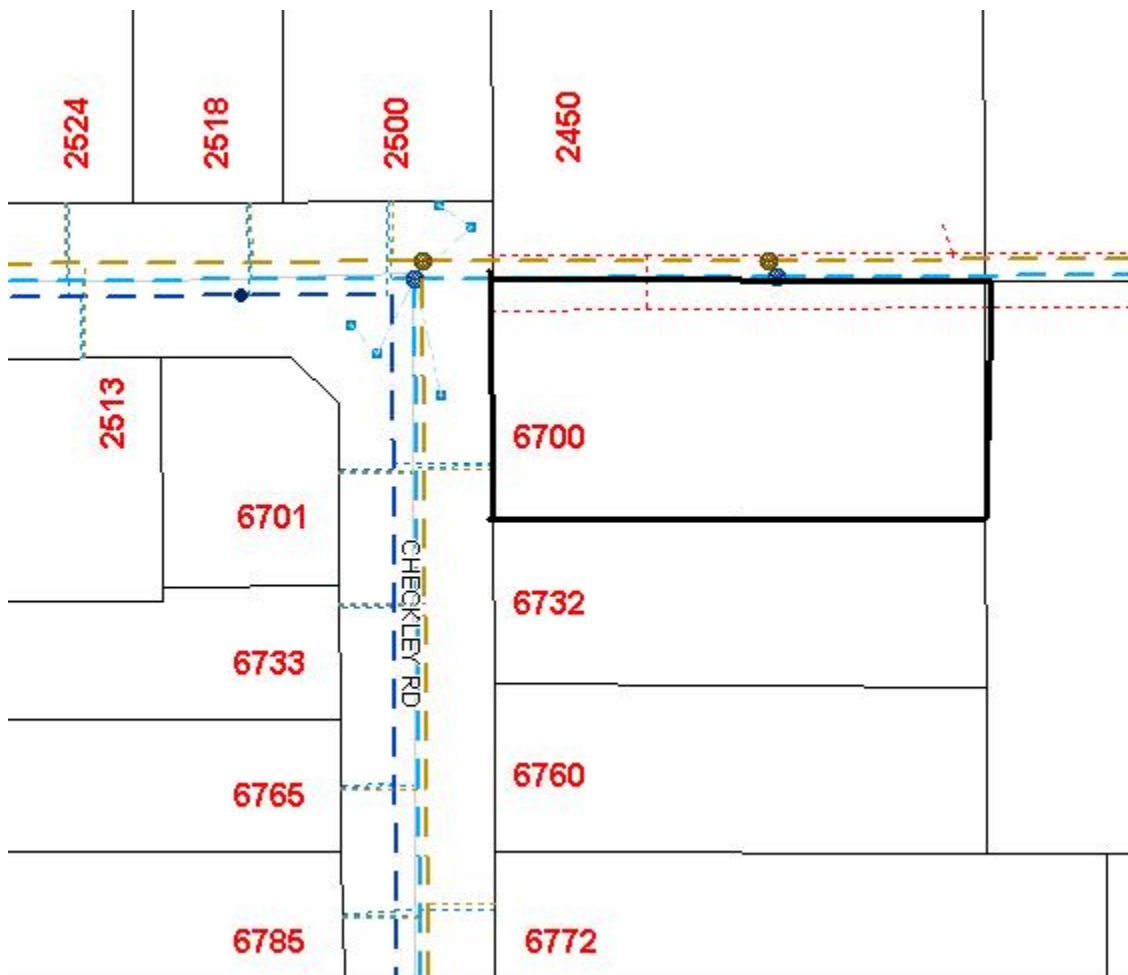

Accuracy not guaranteed unless confirmed by site inspection and/or investigation.  
Connection location between main and property line only.